


Section 35 Township 7 Range 18W

Well No. #1 Bray

Company Moris Sitran

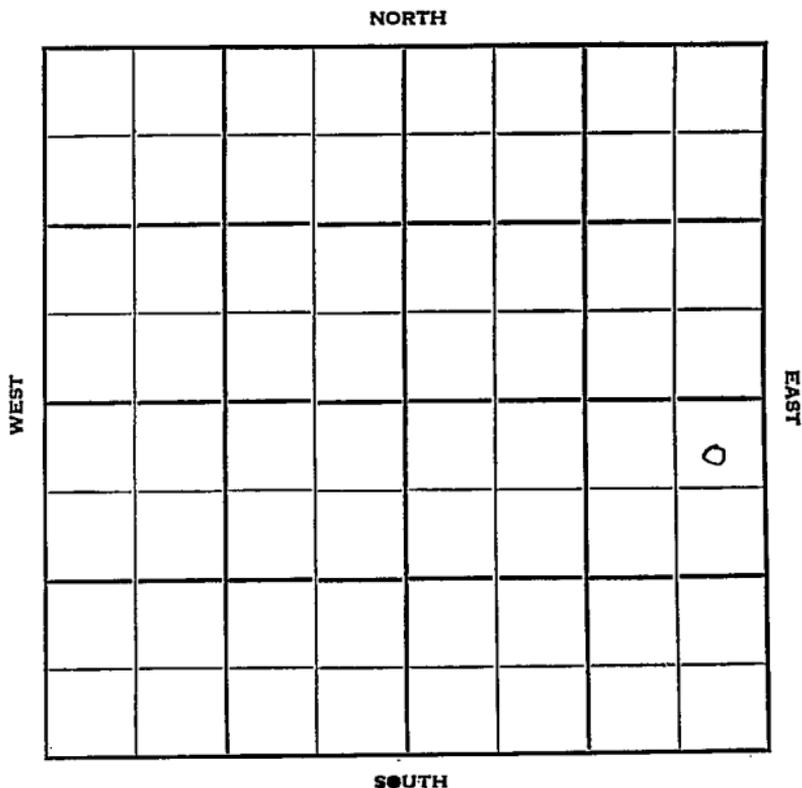

9

Sec. 35 Twp. 7 R. 18W

Well No. #1 Bray Farm

Moris Sitran Company

Murfin - Contr. Contractor

Wildcat


330 Ft. from N. Line

Ft. from S. Line

330' Ft. from E. Line

Ft. from W. Line

NE NE SE

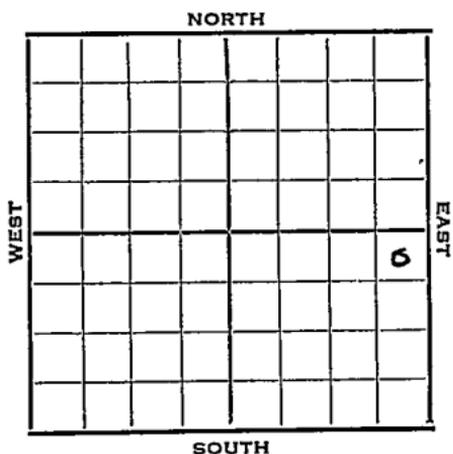

1951 Elev. 1897' REPORT

12/19 Spud 12-16-51
8" @ 216'

1952

1/2 Spud 12-16-51
D&A TD 3385
8" @ 216

Top. 2820

Heeb. 3030

Tor. 3053

Lans. 3072

DST 3075-3120 open 45 min.

Rec. 8' mud TD 3385

D&A

ABANDONED


County Rooks State Kansas

Sec. 35 (Blk. Twp.) 7 (Sur. Rge.) 18W Map No.

Operator Moris Sitran

Well No. 1 Farm Bray

Elev. _____ Location NE NE SE

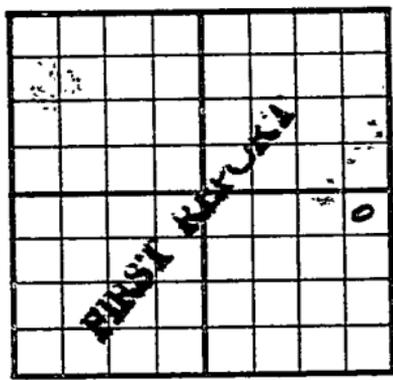

330 Ft. From N Line SE

330 Ft. From E Line Quarter

Ist. Report DEC 1 8 1981

Completion _____

Remarks _____

Murfin - Contr.

Spudding Date 12-16-51

Drlg. Data Wildcat

8" @ 216

J. E. TYRA

