

KANSAS


FORM 51 5M PETROL

Rooks

Section 35 Township 7 Range 17-W

Well No. #1 W. C. Kelly

Company CO-OP & Tom Allan

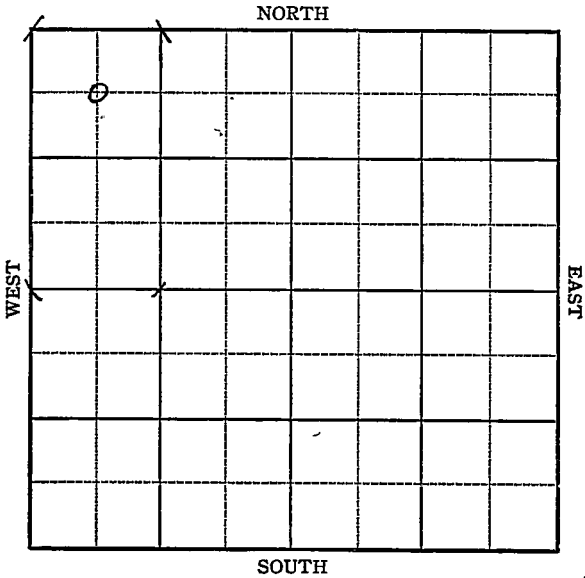


4

Sec. 35 Twp. 7 R. 17-W

Well No. #1 W. C. Kelly Farm
CO-OP & Tom Allan Company

660 Ft. from N. Line
Ft. from S. Line
Ft. from E. Line
660 Ft. from W. Line

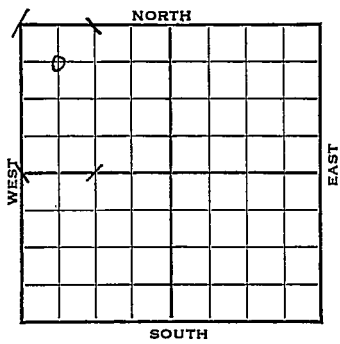

Elev. 1934

1943	REPORT
8/18	Location
8/25	8" @ 106' Drlg. 731'
9/1	Anhy 1234 Neva 2230 Topeka 2777 Lans 3045 T.D. 3074
9/8	5" @ 3074 Rust T.D. 3114 @ 3000 acid
9/15	PB 3108'
9/22	3106 Temp Pot.
9/29	Lans 3045 5" @ 3074' PB 3106' 2000 acid Pump 83 Pot. Gravity 36.4 T.D. 3114'
	COMPLETED

Map No. **KANSAS 64** Sec. **35** Twp. **7** R. **17W**

Well No. **1 W. C. Kelly**

CO-OP & Tom Allan Company

FIRST REPORT Contractor

C NW NW

SECTION PLAT

660 Ft. from N. Line

_____ Ft. from S. Line

_____ Ft. from E. Line

660 Ft. from W. Line

o			

WILD CAT

Location **X**

Rig up _____

Drilling and Remarks:

RECORD

Cased _____ in., _____ ft.

Sand _____

Gas _____

Oil _____

Total Depth _____

PRODUCTION

1st 24 hrs. Nat. _____

1st 24 hrs. after shot _____

Gas _____ Cu. Ft.

Dry Hole _____

Abandoned _____

Date

AUG 1 8 1943 19 _____

S. J. LEWIS Scout

Map No. 64 Sec. 35 Twp. 7 R. 17W

Well No. 1 W.C. Kelly

CO-OP and T. Allen Company

COMPLETED

Contractor

C NW NW

SECTION PLAT

660 Ft. from N. Line

 Ft. from S. Line

 Ft. from E. Line

660 Ft. from W. Line

Wildcat

Location X

Rig up:

Drilling and Remarks:

Liams 3045

5" @ 3074

P.A. 3106

2000 acid

Pump 83 RT.

36 4/8

RECORD

Cased in. ft.

Sand

Gas

Oil

Total Depth 3114

PRODUCTION

1st 24 hrs. Nat.

1st 24 hrs. after shot

Gas Cu. Ft.

Dry Hole

Abandoned

Date

SEP 29 1943 19

S. J. LEWIS Scout