


Section 35 Township 7 Range 18W

Well No. #1 Roelfs

Company Lindas Oil

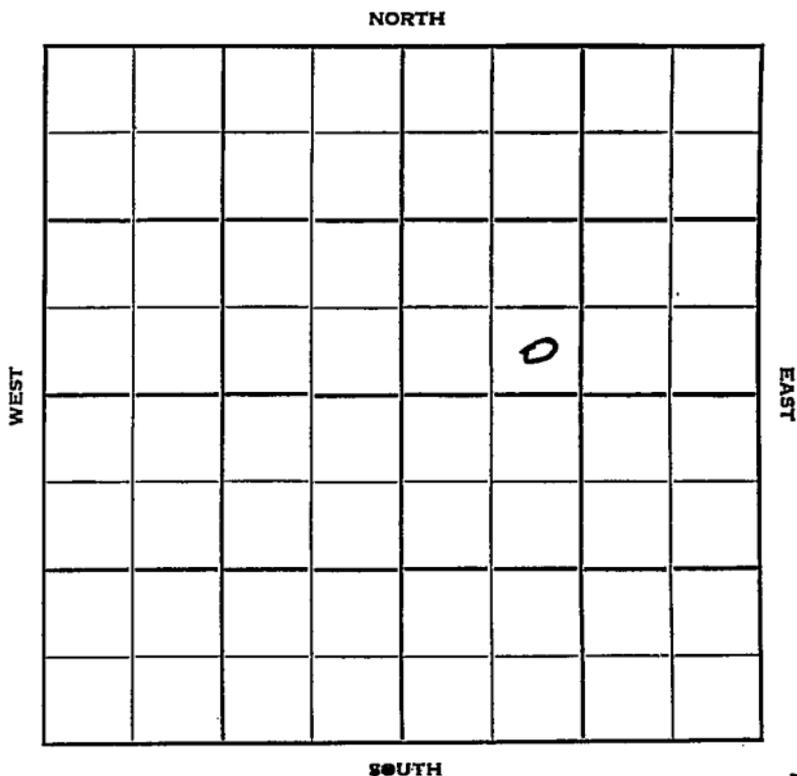

Sec. 35 Twp. 7 R. 18 W

Well No. # 1 Roelfs Farm

Lindas Oil Company

Lindas Contractor


           Ft. from N. Line

330 Ft. from S. Line

           Ft. from E. Line

990 Ft. from W. Line

SE SW NE

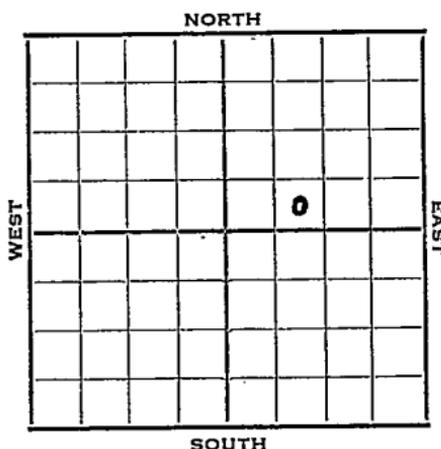

1952

Elev. 1913'

REPORT

6/18

Spud 6-12-52  
8" @ 203  
Anhy 1300'  
Drlg. 2410'


6/25

Spud 6-12-52 D&A TD 3399'  
8" @ 203' Anhy 1300 Heeb. 3050  
Tor. 3080 Lans. 3088  
B KC 3317  
DST 3340-65 open  $\frac{1}{2}$  hr. rec. 15' mud  
Cong. 3383 Arb. 3394  
TD 3399' D&A

**ABANDONED**



County \_\_\_\_\_ Rooks State Kansas  
 Sec. 35 (Blk.) 7 (Sur.) 18W Map No. \_\_\_\_\_  
 Operator Lindas Oil  
 Well No. 1 Farm Roelfs  
 Elev. 1913 Location SE SW NE

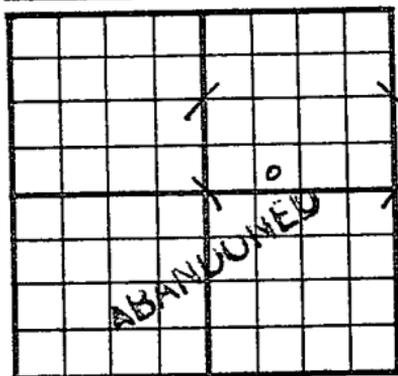

330 Ft. From S Line NE  
990 Ft. From W Line Quarter  
 1st. Report \_\_\_\_\_  
 Completion JUN 25 1952  
 Remarks \_\_\_\_\_  
Lindas - Contr.  
 Spudding Date 6-12-52

Drilg. Data D & A TD 3399  
8" @ 203 Anhy 1300 Heeb. 3050  
Tor. 3080 Lans. 3088 B KC 3317  
DST 3340-65 open  $\frac{1}{2}$  hr. Rec. 15' mud  
Cong. 3383 Arb. 3394 TD 3399  
D & A

J. G. McGEHEE