

Section 35 Township 7 Range 20W

Well No. 1 Wamhoff
Brunson Drlg.

Company _____

Wildcat

NORTH

							0

WEST

EAST

SOUTH

9

KANSAS

Rooks

20W ✓

Sec. 35 Twp. 7 R. 20W

Well No. #1 Wamhoff Farm

Brunson Drlg. Company


Wildcat

330' Ft. from N. Line

_____ Ft. from S. Line

330' Ft. from E. Line

_____ Ft. from W. Line

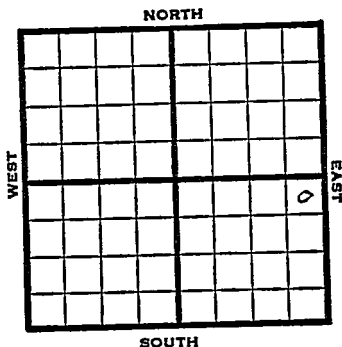

NE SE

1949

Elev 1938' REPORT

5/11

Location

5/18

8" @ 200'

Drlg 1300'

5/25

Lans 3154'

Drlg 3380'

6/1

TD 3469'

Arb. 3415'

Aband.

ABANDONED

Map No. _____ Sec. 35 Twp. 7 R. 20W

Well No. 1 Wamhoff

Brunson Drlg. _____ Company

Brunson Drlg. _____ Contractor

NE SE

FIRST REPORT
SECTION PLAT

330 Ft. from N. Line

_____ Ft. from S. Line

330 Ft. from E. Line

_____ Ft. from W. Line

Rooks County

Location X

Rig up _____

Drilling and Remarks:

RECORD

Cased _____ in., _____ ft.

Sand _____

Gas _____

Oil _____

Total Depth _____

PRODUCTION

1st 24 hrs. Nat. _____

1st 24 hrs. after shot _____

Gas _____ Cu. Ft.

Dry Hole _____

Abandoned _____

Date

MAY 11 1949 19

S. J. LEWIS Scout

Form 26 200 Bks. 9-48 Petrol
Kansas

Wildcat

Map No. 165 Sec. 35 Twp. 7 R. 20W

Well No. 1 Wamhoff

Brunson Drlg.

Company

ABANDONED

Contractor

E. I. 1938

NE SE

SECTION PLAT

330 Ft. from N. Line

_____ Ft. from S. Line

330 Ft. from E. Line

_____ Ft. from W. Line

			0

Rooks County

Location _____

Rig up _____

Drilling and Remarks:

Ca 83415

RECORD

Cased _____ in., _____ ft.

Sand _____

Gas _____

Oil _____

Total Depth 3469

PRODUCTION

1st 24 hrs. Nat. _____

1st 24 hrs. after shot _____

Gas _____ Cu. Ft.

Dry Hole _____

Abandoned _____

Date

JUN 1 1949 19

S. J. LEWIS Scout