

KANSAS

Graham

Section 5 Township 7 Range 25W

Well No. 1 Lindemann

Company Texas

Wildcat

NORTH

WEST

							0

EAST

SOUTH

9

KANSAS Graham

25W

Sec. 5 Twp. 7 R. 25W

Well No. #1 Lindemann Farm

Texas Company

Wildcat


330' Ft. from N. Line

Ft. from S. Line

330' Ft. from E. Line

Ft. from W. Line

NE SE

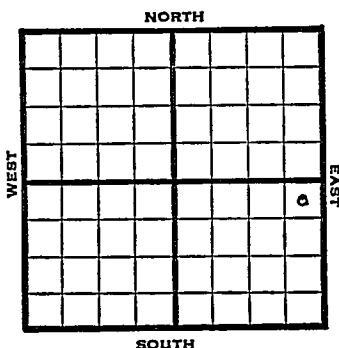

1948

Eli 2525' REPORT

10/27 13" @ 260'

11/3 Drlg. 3696'

11/10 Lansing 3681'

12/22 Viola 4162'

Arb 4174'

Aband.

ABANDONED

Map No. _____ Sec. 5 Twp. 7 R. 25W

Well No. 1 Lindemann

_____ Texas _____ Company

_____ **FIRST REPORT** _____ Contractor

NE SE


SECTION PLAT

330 Ft. from N. Line

_____ Ft. from S. Line

330 Ft. from E. Line

_____ Ft. from W. Line

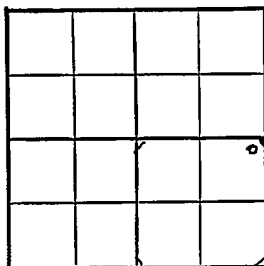

Graham County

Location _____

Rig up _____

Drilling and Remarks:

* 13" @ 260

RECORD

Cased _____ in., _____ ft.

Sand _____

Gas _____

Oil _____

Total Depth _____

PRODUCTION

1st 24 hrs. Nat. _____

1st 24 hrs. after shot _____

Gas _____ Cu. Ft.

Dry Hole _____

Abandoned _____

Date

OCT 27 1948

19

S. J. LEWIS Scout

Kansas

Map No. 67 Sec. 5 Twp. 7 R. 25WWell No. 1 Lindemann


Texas

Company

ABANDONED

Contractor

NE SE

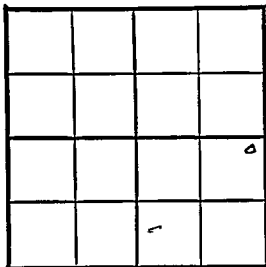E/2525
SECTION PLAT330 Ft. from N. Line Ft. from S. Line330 Ft. from E. Line Ft. from W. Line

Graham County

Location

Rig up

Drilling and Remarks:

*Lease 3681**W/ta 4162**Per 4174*

RECORD

Cased in., ft.Sand Gas Oil Total Depth 4722

PRODUCTION

1st 24 hrs. Nat. 1st 24 hrs. after shot Gas Cu. Ft.Dry Hole Abandoned

Date

NOV 10 1948 19

S. J. LEWIS

Scout