
FORM 51 25M 8-50 WESTERN Sheridan KANSAS

Section 5 Township 7 Range 26W

Well No. #1 Barnett

Company Herndon Drlg.

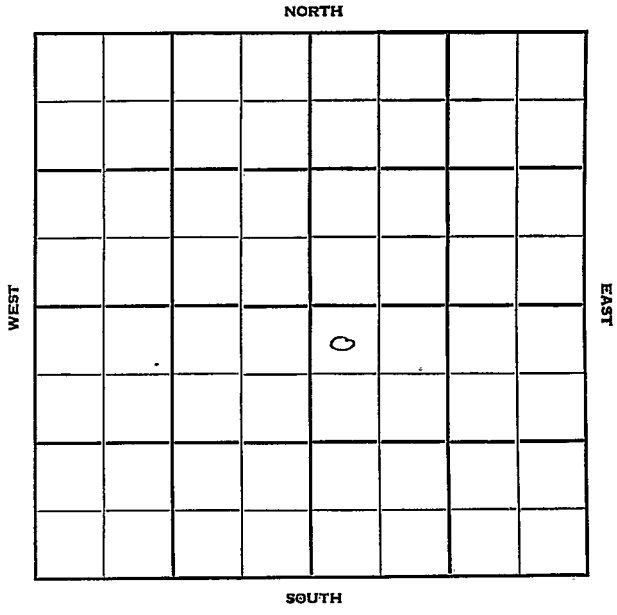

10

FORM 252-B
10M 10-50 PETROL

HOT FILE

Sheridan KANSAS

Sec. 5 Twp. 7 R. 26W

Well No. #1 Barnett Farm

Herndon Drlg. Company

Contractor


Wildcat

330 Ft. from N. Line

Ft. from S. Line

Ft. from E. Line

330 Ft. from W. Line

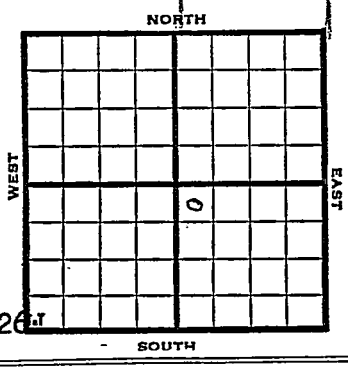

NW NW SE

MCPC has NE/4 of 32-6-26W
& SE/4 of 29-6-26W

1952	Elev. 2624' REPORT
3/5	Location WO Tools
3/12	Location
3/19	8" @ 285 WOC
3/26	Drilling 2500'
4/1	Anhy 1785-1825 TD 3775 SDO
4/9	Spud 3-16-52 D&A TD 4512 8" @ 285 Anhy 1785-1825 TD 3775 Heeb. 3768 Lans. 3812 Marm. 3933 Cong. 4209 Cherty Con. 4302 Miss. 4341 Viola 4442 Arb. 4468 TD 4512 D&A

ABANDONED

FORM 275 FOR SALE BY KANSAS BLUE PRINT CO.


County Sheridan State Kansas

Sec. 5 (Blk. / Twp.) 7 (Sur. / Rge.) 26W Map No.

Operator Herndon Drlg.

Well No. 1 Farm Barnett

Elev. Location NW NW SE

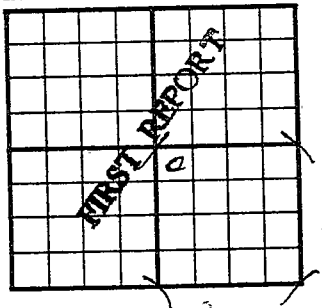

330 Ft. From N Line SE

330 Ft. From W Line Quarter

1st. Report MAR 5 1952

Completion

Remarks MCPC has NE/4 of 32-6-26W and SE/4 of 29-6-26W

Spudding Date

Drlg. Data Wildcat

Location WO tools

J. G. McGEHEE

FORM 275 FOR SALE BY KANSAS BLUE PRINT CO.


County Sheridan State Kansas

Sec. 5 (Blk. Twp.) 7 (Sur. Rge.) 26W Map No.

Operator Herndon Drlg.

Well No. 1 Farm Barnett

Elev. 2624 Location NW NW SE

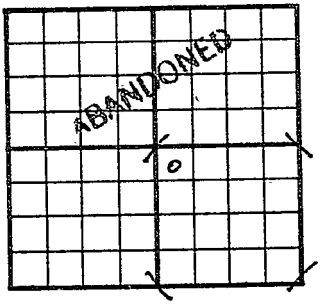

330 Ft. From N Line SE

330 Ft. From W Line Quarter

1st. Report

Completion APR 9 1952

Remarks Wildcat

Spudding Date 3-16-52

Drlg. Data D & A TD 4512

8" @ 285 Anhy 1785-1825 TD 3775

Heeb. 3768 Lans. 3812 Marm. 3933

Cong. 4209 Cherty Con. 4302 miss. 4341

Viola 4442 Arb. 4468 TD 4512

D & A

J. G. McGEHEE