

Section 5 Township 7 Range 17 W

Well No. # 1 Webster

Company T. M. Evans

NORTH

0							

WEST

EAST

SOUTH

12

Sec. 5 Twp. 7 R. 17W

Well No. #1 Webster Farm

T. M. Evans Company

Barnett Contractor

Wildcat


330 Ft. from N. Line

_____ Ft. from S. Line

_____ Ft. from E. Line

330 Ft. from W. Line

NW NW SW

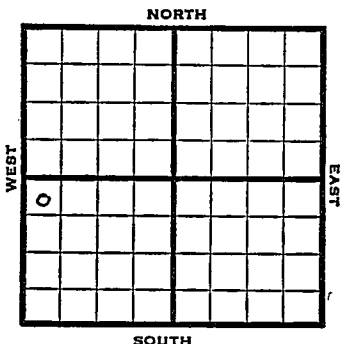

1952 Elev. 1890' REPORT

3/12 Spud 3-9-52
8" @ 165' WOC

3/18 Tite hole

3/26 Spud 3-9-52
D&A TD 3387
8" @ 165 Anhy 1322 Top. 2802
DST 2828-40 open 1 hr. rec. 8' mud
DST 2955-66 open 1 hr. rec. 45' VSOCM
Heeb. 3012 Tor. 3033
Lans. 3055
DST 3056-72 open 1 hr. rec. 15' mud
DST 3230-38 open 1 hr. rec. 8' OCM
B KC 3287 Arb. 3368
TD 3387
D&A

ABANDONED

County **Rooks** State **Kansas**

Sec. **5** (Blk.) **7** (Sur.) **17W** Map No.

Operator **T. M. Evans**

Well No. **1** Farm **Webster**

Elev. Location **NW NW SW**

330 Ft. From **N** Line **SW**

330 Ft. From **N** Line Quarter

1st. Report **MAR 12 1952**

Completion

Remarks

Barnett - Contr.

Spudding Date **3-9-52**

Drlg. Data **Wildcat**

8" @ 165 WOC

J. G. McGEHEE

