Rooks


FORM 51

KANSAS

Section 5 Township 7 Range 18W

Well No. #1 R.O. Brown

Company ~~Murfin Drlg.~~

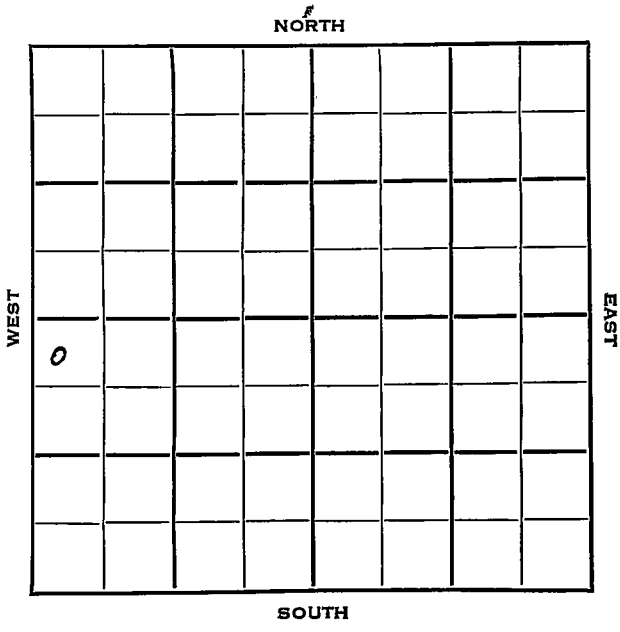


12

Rooks KANSAS

| SEC. | TWP. | R. |
|---|---|---|
| 5 | 7 | 18 W |

WELL NO.

# 1 R. O. Brown FARM
COMPANY

Murfin Drlg.
CONTRACTOR


330 Ft. from N. Line

Ft. from S. Line

Ft. from E. Line

330 Ft. from W. Line

NW NW SW

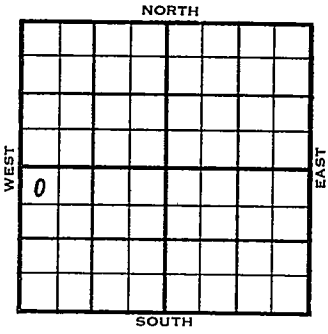


| 1954 | ELEVATION 1927' REPORT |
|---|---|
| 3/17 | MIR |
| 3/24 | 8" @ 187 Anhy 1450<br>Drlg. 2870 |
| 3/31 | Spud 3-18-54<br>D & A<br>TD 3510'<br>8" @ 187'<br>Anhy 1450', Top 2931', Heeb 3102'<br>Lans 3142' Cong 3452' Arb 3459'<br>TD 3510'<br>D & A |

ABANDONED

DX-78

FORM 275 FOR SALE BY KANSAS BLUE PRINT CO.


County Rooks State Kansas

Sec. 5 (Blk. Twp.) 7 (Sur. Rge.) 18W Map No.

Operator Murfin Drlg.

Well No. 1 Farm R. O. Brown

Elev. Location NW NW SW

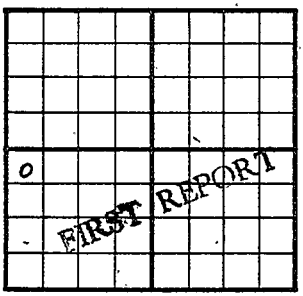


330 Ft. From N Line SW

330 Ft. From W Line Quarter

1st. Report MAR 17 1954

Completion

Remarks

Spudding Date

Drlg. Data

M I R

J. G. McGEHEE

FORM 275 FOR SALE BY KANSAS BLUE PRINT CO.


County Rooks State Kansas

Sec. 5 (Blk. Twp.) 7 (Sur. Rge.) 18W Map No.

Operator Murfin Drlg.

Well No. 1 Farm R. O. Brown

Elev. 1927 Location NW NW SW

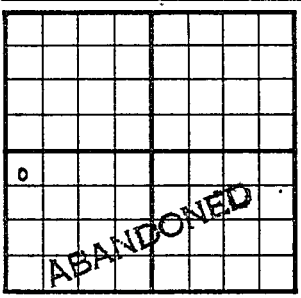


330 Ft. From N Line SW Quarter

330 Ft. From W Line

1st. Report

Completion MAR 31 1954

Remarks

Spudding Date 3-18-54

Drlg. Data D & A TD 3510

8" @ 187 Anhy 1450 Top. 2931

Heeb. 3102 Lans. 3142 Cong. 3452

Arb. 3459 TD 3510

D & A

J. G. McGEHEE