
FORM 51 25M 8-50 WESTERN Rooks KANSAS

Section 6 Township 7 Range 20 W

Well No. # 1 Loeffler

Company Deep Rock

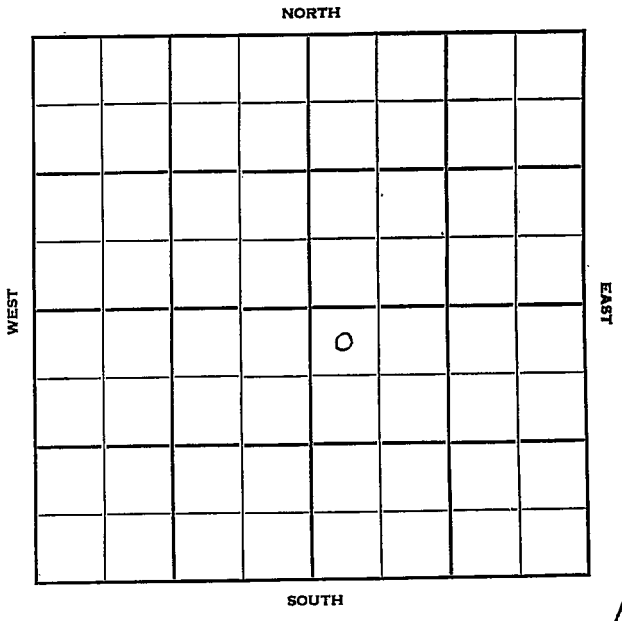

10

FORM 252-B
10M 11-50 PETROL

Rooks

KANSAS 20W ✓

Sec. 6 Twp. 7 R.

Well No. #1 Loeffler Farm

Deep Rock Company

Contractor

Wildcat


330' Ft. from N. Line

Ft. from S. Line

Ft. from E. Line

330' Ft. from W. Line

NW NW SE

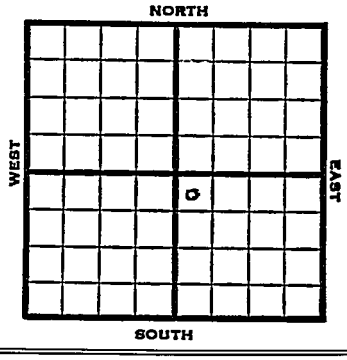

1951	Elev. 2234' REPORT
4/25	RUR
5/9	Spud 4-25-51 D & A TD 3810' 8" @ 212 DST 3392-3409' open 1 hr. rec 170' wtr. Heeb 3429', KC 3459', DST 3462-87 open ½ hr. rec 60' mud B KC 3667' Cong 3730', Arb. 3784' TD 3810' D & A **ABANDONED**

FORM 275 FOR SALE BY KANSAS BLUE PRINT CO.


County Rooks State Kansas

Sec. 6 (Blk. / Twp.) 7 (Sur. / Rge.) 20W Map No.

Operator Deep Rock

Well No. 1 Farm Loeffler

Elev. Location NW NW SE

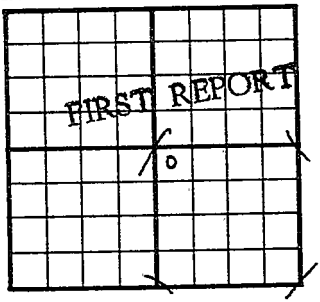

330 Ft. From N Line SE

330 Ft. From W Line Quarter

1st. Report APR 25 1951

Completion

Remarks Mag., Sun & Sunray IHM

Spudding Date

Drlg. Data Wildcat

R U R

J. E. TYRA

FORM 275 FOR SALE BY KANSAS BLUE PRINT CO.


County Rooks State Kansas

Sec. 6 (Blk. Twp.) 7 (Sur. Rge.) 20W Map No.

Operator Deep Rock

Well No. 1 Farm Loeffler

Elev. 2234 Location NW NW SE

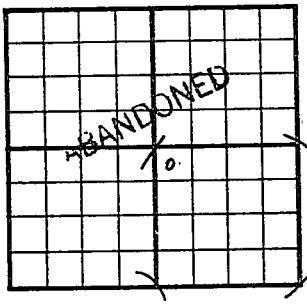

330 Ft. From N Line SE

330 Ft. From W Line Quarter

1st. Report

Completion MAY 9 1951

Remarks Wildcat

Spudding Date 4-25-51

Drlg. Data D & A TD 3810

8" @ 212 DST 3392-3409 open 1 hr.

Rec. 170' water Heeb. 3429 KC 3459

DST 3462-87 open ½ hr. Rec. 60' mud

B KC 3667 Cong. 3730 Arb. 3784

TD 3810 D & A

J. E. TYRA