


Graham

Section 7 Township 7 Range 22-W
~~20-W~~

Well No. #1 Scott

Company Mavis Child Motor

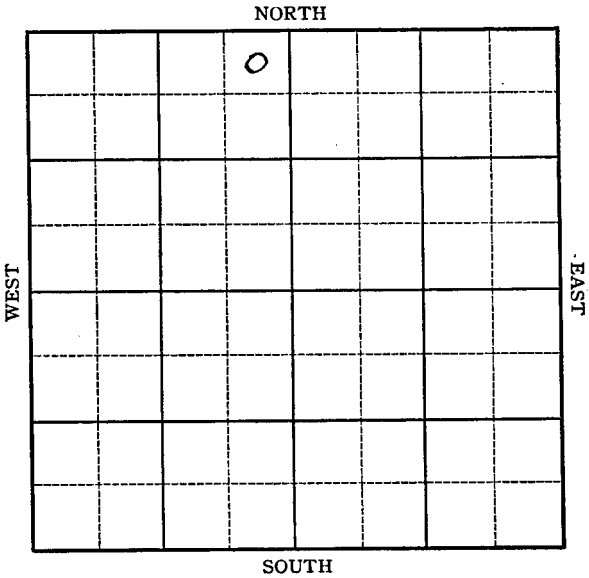

3

Sec. 7 Twp. 7 R.

Well No. #1 Scott Farm


Davis Child Company

330 Ft. from N. Line

 Ft. from S. Line

 Ft. from E. Line

330 Ft. from W. Line

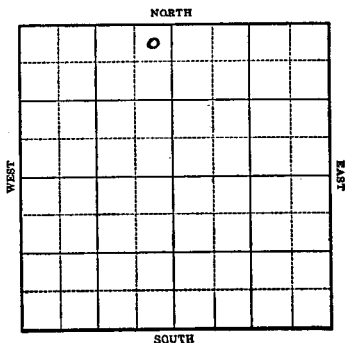

1943

R E P O R T

11/24 Location.
12/1 10" @ 188 WOC
12/8 Anhy 1965
Drlg. 3342

12/15 Lans 3593
Arb 3946
TD 4000

ABANDONED

Map No. 66 Sec. 7 Twp. 7 R. 22W

Well No. 1 Scott

Davis Child Motor Company

CORRECTION Contractor

NE NW

330 Ft. from N. Line

_____ Ft. from S. Line

330 Ft. from E. Line

_____ Ft. from W. Line

SECTION PLAT

		o	

Wildcat

Location _____

Rig up _____

Drilling and Remarks:

Reported

7-7-20W

RECORD

Cased _____ in., _____ ft.

Sand _____

Gas _____

Oil _____

Total Depth _____

PRODUCTION

1st 24 hrs. Nat. _____

1st 24 hrs. after shot _____

Gas _____ Cu. Ft.

Dry Hole _____

Abandoned _____

Date

NOV 24 1943

19

S. J. LEWIS Scout

KANSAS

Map No. 65 Sec. 7 Twp. 7 R. 20WWell No. 1 ScottDavis Child Motor CompanyFIRST REPORT Contractor

NE NW


SECTION PLAT

330 Ft. from N. Line

Ft. from S. Line

330 Ft. from E. Line

Ft. from W. Line

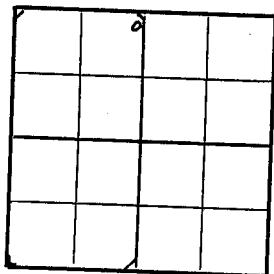

Wildcat

Location X

Rig up _____

Drilling and Remarks: _____

RECORD

Cased _____ in., _____ ft.

Sand _____

Gas _____

Oil _____

Total Depth _____

PRODUCTION

1st 24 hrs. Nat. _____

1st 24 hrs. after shot _____

Gas _____ Cu. Ft.

Dry Hole _____

Abandoned _____

Date

NOV 24 1943 19

S. J. LEWIS Scout

Map No. 46 Sec. 7 Twp. 7 R. 22WWell No. 1 ScottDavis Child Motor CompanyABANDONED Contractor

NE NW


SECTION PLAT

330 Ft. from N. Line

_____ Ft. from S. Line

330 Ft. from E. Line

_____ Ft. from W. Line

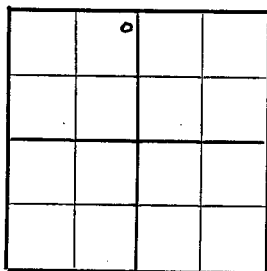

Wildcat

Location _____

Rig up _____

Drilling and Remarks:


RECORD

Cased _____ in., _____ ft.

Sand _____

Gas _____

Oil _____

Total Depth 4000

PRODUCTION

1st 24 hrs. Nat. _____

1st 24 hrs. after shot _____

Gas _____ Cu. Ft.

Dry Hole _____

Abandoned _____

Date

DEC 15 1943 19

S. J. LEWIS Scout