

8

7

25 W

Section _____ Township _____ Range _____

Well No. # 1 Abernathy

Company Hall-Jones & Berwick

NORTH

WEST

EAST

0

SOUTH

10

SEC.	TWP.	R.
8	7	25W

WELL NO.

1 Abernathy

FARM

COMPANY

Hall-Jones & Berwick

CONTRACTOR

330 Ft. from N. Line


Ft. from S. Line

Ft. from E. Line

330 Ft. from W. Line

NW NW SE


Magnolia F/O

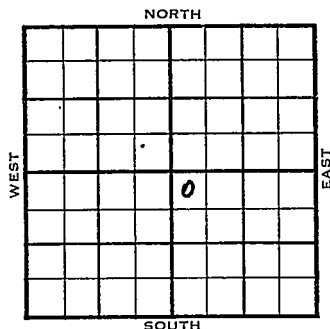

	ELEVATION	REPORT
1953	2529'	
12/30	Spud 11-30-53 Drlg. 2745'	
1954 1/6	Spud 11-30-53 D & A TD 4230 Heeb 3642 Lans 3686 DST 3720-3820 open 3/4 hr, rec 45' mud 700# B KC 3889 Miss 4121 Viola 4154 Arb. 4207' TD 4230' D & A	
	ABANDONED	

J. G. McGEHEE

County Graham State Kansas
 Sec. 8 (Blk.) 7 (Sur.) 25W Map No.
 Operator Hall-Jones & Berwick
 Well No. 1 Farm Abernathy
 Elev. 2529 Location NW NW SE

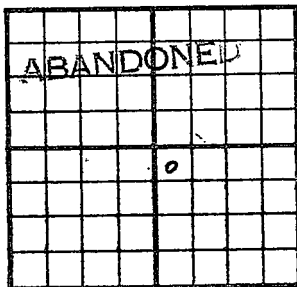

330 Ft. From N Line SE
330 Ft. From W Line Quarter
 Ist. Report JAN 6 1954
 Completion
 Remarks

Spudding Date 11-30-53

Dflg. Data D & A TD 4230

Heeb. 3642 Lans. 3686 DST 3720-3820

open $3/4$ hr. Rec. 45' mud 700#

B. KC 3889 Miss. 4121 Viola 4154

Arb. 4207 TD 4230

D & A

J. G. McGEHEE