

Section 8 Township 7 Range 20W

Well No. 1 Felderman

Company Sam Pack

Wildcat
NORTH

| | | | | | | | |
|--|--|--|--|--|--|--|---|
| | | | | | | | 0 |
| | | | | | | | |
| | | | | | | | |
| | | | | | | | |
| | | | | | | | |
| | | | | | | | |
| | | | | | | | |
| | | | | | | | |

WEST

EAST

SOUTH

KANSAS

Rooks ✓
20W

Sec. 8 Twp. 7 R. 20W

Well No. 1 Felderman Farm

Sam Pack Company

Wildcat


330 Ft. from N. Line

_____ Ft. from S. Line

330 Ft. from E. Line

_____ Ft. from W. Line

NE/C

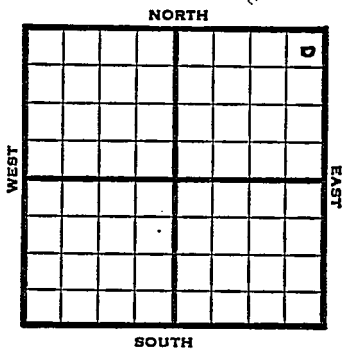

1948

Eli 2180' REPORT

11/17 8" @ 166'
Drlg. 2840'

11/23 Lansing 3419'
Arb. 3682'
Drlg 3722'

12/1 TD 3732'
Arb. 3682'
Aband.

ABANDONED

Map No. _____ Sec. 8 Twp. 7 R. 20W

Well No. 1 Felderman

Sam Pack Company

FIRST REPORT Contractor

NE/C

SECTION PLAT

330 Ft. from N. Line

_____ Ft. from S. Line

330 Ft. from E. Line

_____ Ft. from W. Line

| | | | |
|--|--|--|--|
| | | | |
| | | | |
| | | | |
| | | | |

Rooks County

Location _____

Rig up _____

Drilling and Remarks:

8" @ 166

drlg. 2840

RECORD

Cased _____ in., _____ ft.

Sand _____

Gas _____

Oil _____

Total Depth _____

PRODUCTION

1st 24 hrs. Nat. _____

1st 24 hrs. after shot _____

Gas _____ Cu. Ft.

Dry Hole _____

Abandoned _____

Date

NOV 17 1948 19

S. J. LEWIS Scout

Kansas

Map No. 65 Sec. 8 Twp. 7 R. 20W

Well No. 1 Felderman

Sam Paek Company

ABANDONED

Contractor

NE/C

E1,2170

SECTION PLAT

330 Ft. from N. Line

_____ Ft. from S. Line

330 Ft. from E. Line

_____ Ft. from W. Line

| | | | |
|--|--|--|--|
| | | | |
| | | | |
| | | | |
| | | | |

Rooks County

Location _____

Rig up _____

Drilling and Remarks:

Per #8672

RECORD

Cased : _____ in., _____ ft.

Sand _____

Gas _____

Oil _____

Total Depth 8722

PRODUCTION

1st 24 hrs. Nat. _____

1st 24 hrs. after shot _____

Gas _____ Cu. Ft.

Dry Hole _____

Abandoned _____

Date

DEC 1 1948 19

S. J. LEWIS Scout