KANSAS


FORM 51 5M 10-41 PETROL

Rooks

Section 9 Township 7 Range 17-W

Well No. #1 Oliva

Company Carter Oil

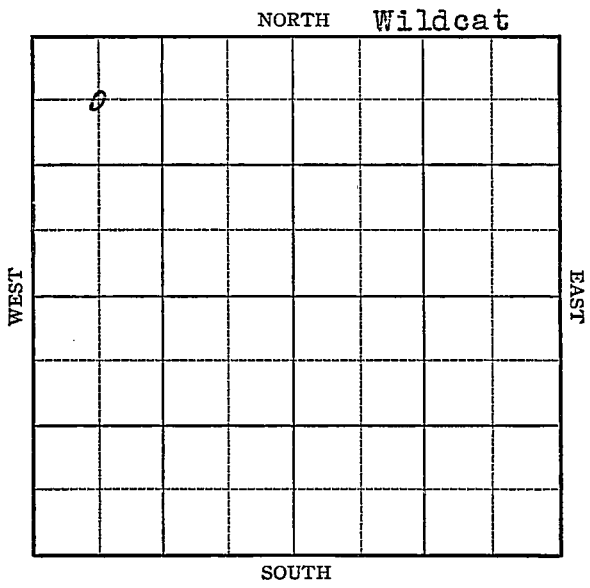

4

FORM 252-A
5M 10-41 PETROL

KANSAS Rooks

Sec. 9 Twp. 7 R. 17-W

Well No. #1 Oliva Farm

Carter Oil Company


(Wildcat)

660 Ft. from N. Line

_____ Ft. from S. Line

_____ Ft. from E. Line

660 Ft. from W. Line

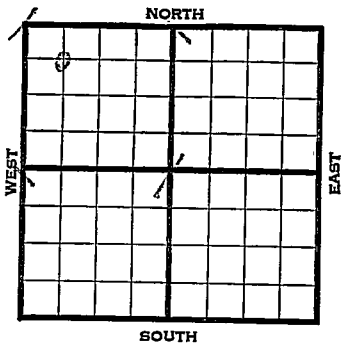

Elev. 1914

1942	REPORT
3/18	Location
3/26	8" - 313' Drlg. 1772'
4/2	Topaka 2803' S.O. 2830-32, 2955-61
	Lans. 3054' Coring 3149'
4/8	No Viola.
	Arb. 3369'
	T.D. 3470'
	No shows.
	ABANDONED

Form 26 200 Bks. 5-41 McW. Rooks KANSAS

Map No. 64 Sec. 9 Twp. 7 R. 17W

Well No. 1 Oliva

Carter Oil Company

FIRST REPORT Contractor

C NW NW


660 Ft. from N. Line

_____ Ft. from S. Line

_____ Ft. from E. Line

660 Ft. from W. Line

SECTION PLAT

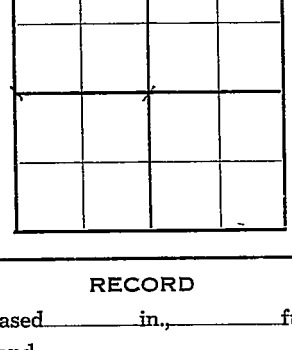

WILDCAT

Location XXX

Rig up

Drilling and Remarks:

RECORD

Cased ____ in., ____ ft.

Sand

Gas

Oil

Total Depth

PRODUCTION

1st 24 hrs. Nat.

1st 24 hrs. after shot

Gas ____ Cu. Ft.

Dry Hole

Abandoned

Date

MAR 1 8 1942 19

S. I. LEWIS Scout

Form 26 200 Bks. 5-41 McW.

Rooks KANSAS

Map No. 64 Sec. 9 Twp. 7 R. 17W

Well No. 1 Oliva

Carter Oil Company

ABANDONED Contractor

C NW NW


660 Ft. from N. Line

____ Ft. from S. Line

____ Ft. from E. Line

660 Ft. from W. Line

SECTION PLAT

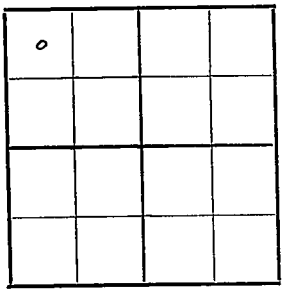

WILDCAT

Location

Rig up

Drilling and Remarks:

No Viola

Cir @ 3369

Nochows

RECORD

Cased ____ in., ____ ft.

Sand

Gas

Oil

Total Depth 3470

PRODUCTION

1st 24 hrs. Nat.

1st 24 hrs. after shot

Gas ____ Cu. Ft.

Dry Hole

Abandoned

Date

APR 8 1942 19 S. J. LEWIS Scout