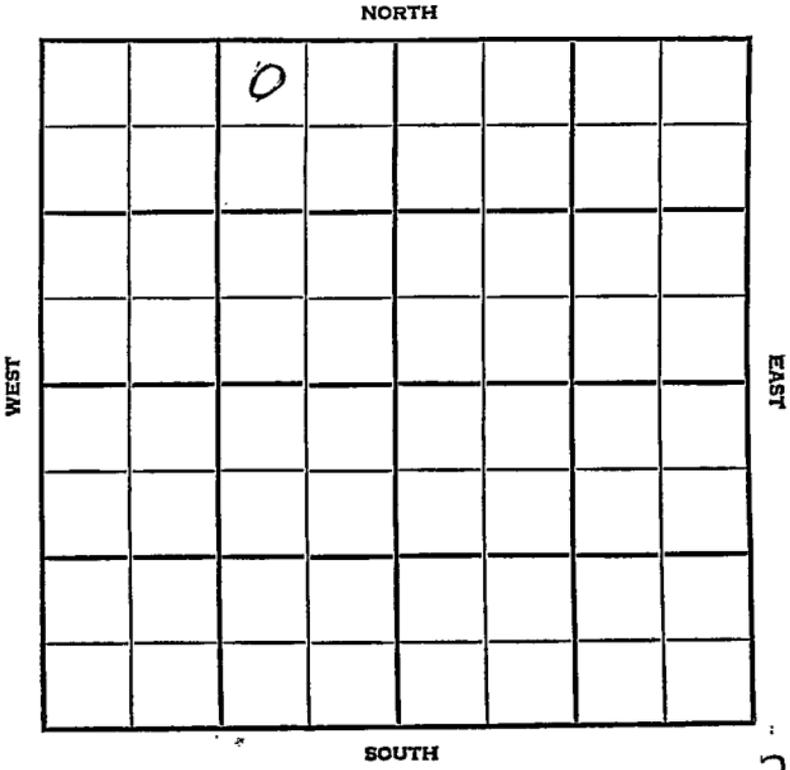


Section # 9 Township 7 Range 19W

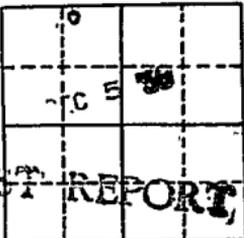
Well No. #1 Desmarteau

Company Sierra Petroleum



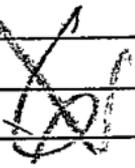
County Rooks Elev. 1981
 Sec. 9 Twp. 7 Rge. 19W
 Company Sierra Petroleum
 FarmName Desmarteau No. 1

TOPS	DEPTH	LOG	DATUM
Anh.			
TP.			
H.			
Tr.			
Dg.			
Bl.			
L.			
K.C.			
B.K.C.			
Ce.			
C.			
M.			
M.			
K.			
Mz.			
Mo.			
V.			
S.			
S.			
A.			
R.			
PE.			
G.			
TD.			

Loc. in Sec. NW NE NW
 Geol. _____
 Contr. _____
 Pool Riffe

WELL REPORT

Date Comm. 11-28-56

8" @ 205' w/140, Drlg. 3280



Co.

Lse.

No.

Sec.

T.

R.

County Hook Elev. 1981
 Sec. 9 Twp. 7 Rge. 19W
 Company Sierra Petroleum
 Farm Name Desmarteau No. 1

TOPS	DEPTH	LOG	DATUM	Loc. in Sec.
Anh.				NE NE NW
Ip.				
H.	<u>3144</u>			
Tr.	<u>3170</u>			
Dg.				
BL.				
L.	<u>3187</u>			Geol.
K.C.				Contr.
B.K.C.				
Ce.				
E.				
M.				Pool
M.				Riffe
K.				
Mz.				
Ma.				
V.				
S.				
S.				
A.	<u>3475</u>			
R.				
Pe.				
G.				
TR.	<u>3481</u>			

DEC 26 '56
 ABANDONED

Date Comm. 11-28-56

8" @ 205 w/140, Drlg. 3280 DEC 12 '56
DST 3246-80 30" rec 3' V50cm
BHP 0 DST 3319-46 30" rec
5' md BHP 0 DST 3346-.90
45" rec 10' md BHP 0 DST
3476-81 1hr rec 15' oil + 30'
HOCM BHP 740 5 1/2 @ 3479/50
DEC 19 '56 CO 3481 @ 20 GFPH 80%
wt 3 hrs 1/4 @ 1 1/3 BFPH 80%

Wt 9 hrs 11/2 \$1d DEC 25 1948

Failed to rec Ld.

DCA

9-7-19

nu ne nu