

Rocks


FORM 51 25M 8-50 WESTERN

KANSAS

Section 9 Township 7 Range 19W

Well No. #1 Anderson

Company Francis O & G

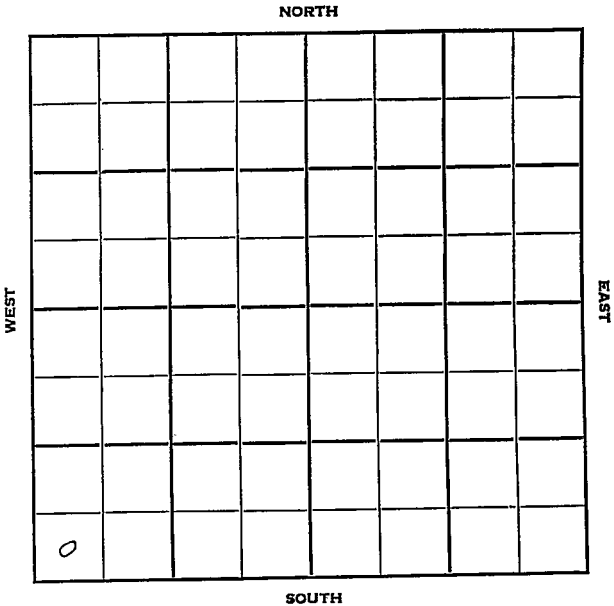

13

Rooks

KANSAS

Sec. 9 Twp. 7 R. 19 W

Well No. # 1 Anderson Farm

Francis Oil & Gas Company

Contractor

Wildcat

Ft. from N. Line


330 Ft. from S. Line

Ft. from E. Line

330 Ft. from W. Line

SW SW SW

Gulf & Skelly DHM

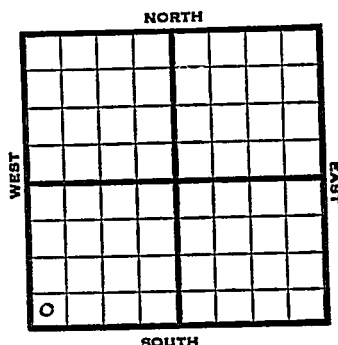

1951 Elev. 1938' REPORT

4/11 Spud 4-3-51
8" @ 220 Anhy 1440', Heeb 3086',
Dodge 3112', Lans. 3130',
DST 3114-41' open 1 hr. Rec. 100' SOCM
580#
Drlg.

6/20 Spud 4-3-51
Oil Well TD 3409
8" @ 220
Anhy 1440 Heeb. 3086
Dodge 3112 Lans. 3130
DST 3114-41 opn 1 hr
Rec. 100' socm
Cong. 3386
SO 3388-92 Arb. 3398
DST 3393-3403 opn 1 1/4 hr.
Rec 90' free oil 3' mud
5" @ 3399 TD 3403
S/ 3/4 bfph 10% wtr 750A 1500 A
S/1 1/4 bfph 14% wtr 9/3400-03
P/30 bo 15 bwpd Comp. 28 bopd
30% wtr. **COMPLETED**

County Rooks State Kansas
 Sec. 9 (Blk.) 7 (Sur.) 19W Map No.
 Operator Francis Oil & Gas
 Well No. 1 Farm Anderson
 Elev. _____ Location SW SW SW

0							

330 Ft. From S Line SW330 Ft. From W Line Quarter1st. Report APR 11 1951

Completion _____

Remarks Gulf & Skelly IHMSpudding Date 4-3-51

Drlg. Data _____

Wildcat8" @ 220 Anhy 1440 Heeb. 3086Dodge 3112 Lans. 3130 DST 3114-41open 1 hr. Rec. 100⁺ soom 580# drlg.

J. E. TYRA

J. E. TYRA