

Rooks

KANSAS

Sec. 1 Twp. 8 R. 18W

Well No. #1 Williams Farm

Murfin Drlg. Company

Murfin Drlg. - Contr. Contractor

Wildcat


..... Ft. from N. Line

330' Ft. from S. Line

..... Ft. from E. Line

330' Ft. from W. Line

SW SW SE

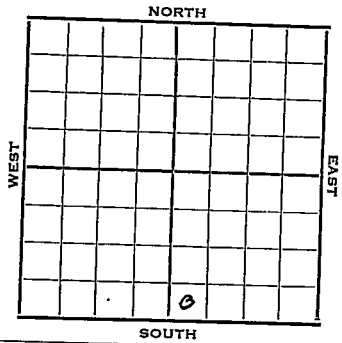

1952

Elev. 1869' REPORT

5/14

Spud 5-10-52
8" @ 159

5/21

Drlg. 1508'
Topeka 2800 Heeb. 3010
Tor. 3036 Lans. 3052
DST 3136-55 1 hr. 160' WGM
1100# Drlg. 3255'

5/28

Spud 5-10-52
D & A TD 3380' 8" @ 159 Top 2800
Heeb 3010' Tor. 3036' Lans. 3052'
DST 3136-55 open 1 hr. rec 160' WGM
Cong. 3329' Arb. 3349'
DST 3349-56 open 3/4 hr. rec 8' mud
TD 3380' D & A

ABANDONED.


County _____ Rooks State Kansas

Sec. 1 (Blk.) 8 (Sur.) 18W Map No. _____
(Twp.) (Rge.)

Operator Murfin Drlg.

Well No. 1 Farm Williams

Elev. 1869 Location SW SW SE

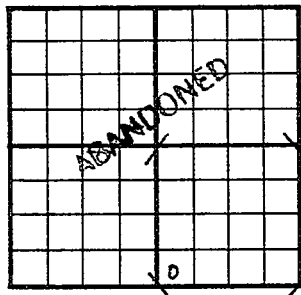

330 Ft. From S Line SE

330 Ft. From W Line Quarter

Ist. Report _____

Completion MAY 28 1952

Remarks Wildcat

Murfin Drlg. - Contr.

Spudding Date 5-10-52

Drlg. Data D & A TD 3380

8" @ 159 Top. 2800 Heeb. 3010

Tor. 3036 Lans. 3052 DST 3136-55

open 1 hr. Rec. 160' wcm Cong. 3329

Arb. 3349 DST 3349-56 open 3/4 hr.

Rec. 8' mud TD 3380

D & A