

Sheridan

KANSAS

1

8

26W

SECTION _____ TOWNSHIP _____ RANGE _____

WELL NO. #1 Davis

COMPANY Empire Oil Co.

NORTH

							0

WEST

EAST

SOUTH

Sheridan

KANSAS

SEC.

1

TWP.

8

R.

26W

WELL NO.

#1 Davis

FARM

COMPANY

Empire Oil Co

CONTRACTOR

Empire Drlg Co


Wildcat

_____ FT. FROM N. LINE

_____ FT. FROM S. LINE

_____ FT. FROM E. LINE

_____ FT. FROM W. LINE

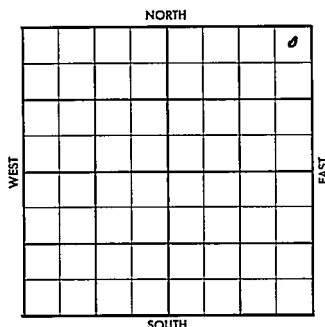

SDX Lse = 1/2 mi

NE NE NE

ELEVATION

1956

REPORT

9-5

8" @ 300

County Sheridan Elev. _____
Sec. 1 Twp. 8 Rgs. 26W
Company Empire Oil Co.
Farm Name Davis No. 1

TOPS	DEPTH	LOG	DATUM
Anh.			
Top.			
H.			
Tr.			
Dg.			
Bl.			
L.			
K.C.			
B.K.C.			
Ce.			
C.			
M.			
M.			
K.			
Mz.			
Ma.			
V.			
S.			
S.			
A.			
R.			
Pe.			
G.			
T.D.			

Loc. in Sec. _____
NE NE NE
Geol. _____
Contr. _____
Empire Drlg.
Pool _____
Wildcat

2 MINE
FIRST REPORT
SEP 5 '50

Date Comm. 8" @ 300

33
1121
1121

Co.

Leg.

No.

Sec.

T.

R.

Co.

County Sheridan Elev. 2452
 Sec. 1 Twp 8 Rge. 26
 Company Union Oil Co.
 Name Davis No. 1

TOPS	DEPTH	LOG	DATUM	Loc. in Sec.
	<u>240</u>			NE NE NE
Tp.				
H.	<u>3237</u>			
Tr.	<u>3659</u>			
Dg.				
Bl.				
L.	<u>3675</u>			Geol.
K.C.				Contr.
B.K.C.				Empire Drll.
Ce.				Pool
C.				Goldcat
M.				SEP 19 56
M.				1/2 mile
K.				ABANDONED
Mz.				
Mo.				
V.				
S.				
S.				
A.				
R.				
Pe.				
G.				
TD.	<u>3900</u>			

L.

No.

Sec.

T.

R.

Date Comm. Imperial F.O.

BHT @ 36

SEP 12 '56

DST 3690-3715 SEP 19 56 up 1 hr.
 see 35' Md (550) BHT 1240
 DST 3792-3815 1 hr see
 5' Md BHT 0

D & A.