


Rooks

Section 10 Township 8 Range 17-W

Well No. 1 Leist


Company Carter

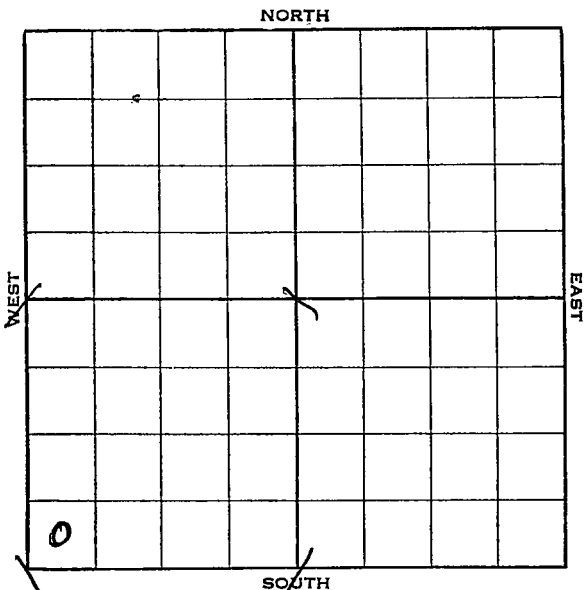

Sec. 10 Twp. 8 R. 17-W

Well No. #1 Leist Farm \_\_\_\_\_  
Carter Company \_\_\_\_\_

\_\_\_\_\_ Ft. from N. Line  
330 Ft. from S. Line  
 \_\_\_\_\_ Ft. from E. Line  
330 Ft. from W. Line  
 Elev. 1969

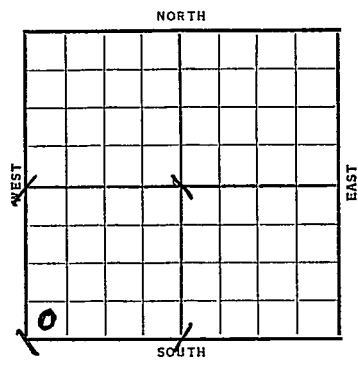

Date	REPORT
1938	
3/23	B.R.R.
4/1	R U R
4/8	8" @ 707'. Anhy 1347'.
	Drlg. 1910'.
4/15	Drlg. 2663'.
4/22	Topeka 2907'. K. C. 3145'.
	Drlg. 3315'. No shows.
4/27	Arb. 3489'.
	T.D. 3508'.
	No shows.

**ABANDONED**

Map No. 64 Sec. 10 Twp. 8 R. 17WWell No. 1 LeistCarter Company

Contractor

## FIRST REPORT

SW/C

Ft. from N. Line

330 Ft. from S. Line

Ft. from E. Line

330 Ft. from W. Line**Special**

## SECTION PLAT


Location \_\_\_\_\_

Rig up \_\_\_\_\_

Drilling and Remarks:

BRR

## RECORD

Cased \_\_\_\_\_ in., \_\_\_\_\_ ft.

Sand \_\_\_\_\_

Gas \_\_\_\_\_

Oil \_\_\_\_\_

Total Depth \_\_\_\_\_

## PRODUCTION

1st 24 hrs. Nat. \_\_\_\_\_

1st 24 hrs. after shot \_\_\_\_\_

Gas \_\_\_\_\_ Cu. Ft.

Dry Hole \_\_\_\_\_

Abandoned \_\_\_\_\_

Date

MAR 23 1938

19

H. D. Hatfield Scout

Rooks

KANSAS

Map No. 64 Sec. 10 Twp. 8 R. 17W

Well No. 1 Leist

Carter Oil

Company

Contractor

ABANDONED

SW/C

         Ft. from N. Line

330 Ft. from S. Line

         Ft. from E. Line

330 Ft. from W. Line

SECTION PLAT

0			

Location                                 

Rig up                                 

Drilling and Remarks:

*No shows*

*DYA*

RECORD

Cased          in.,          ft.

Sand Arb 3489

Gas                                 

Oil                                 

Total Depth 3508

PRODUCTION

1st 24 hrs. Nat.                         

1st 24 hrs. after shot                         

Gas                                  Cu. Ft.

Dry Hole                                 

Abandoned                                 

Date

APR 27 1938

H. D. Hatfield Scout