


DX 78-1 Graham

KANSAS

Section 10 Township 8 Range 25W

Well No. #1 Foltz

Company Empire Drlg.

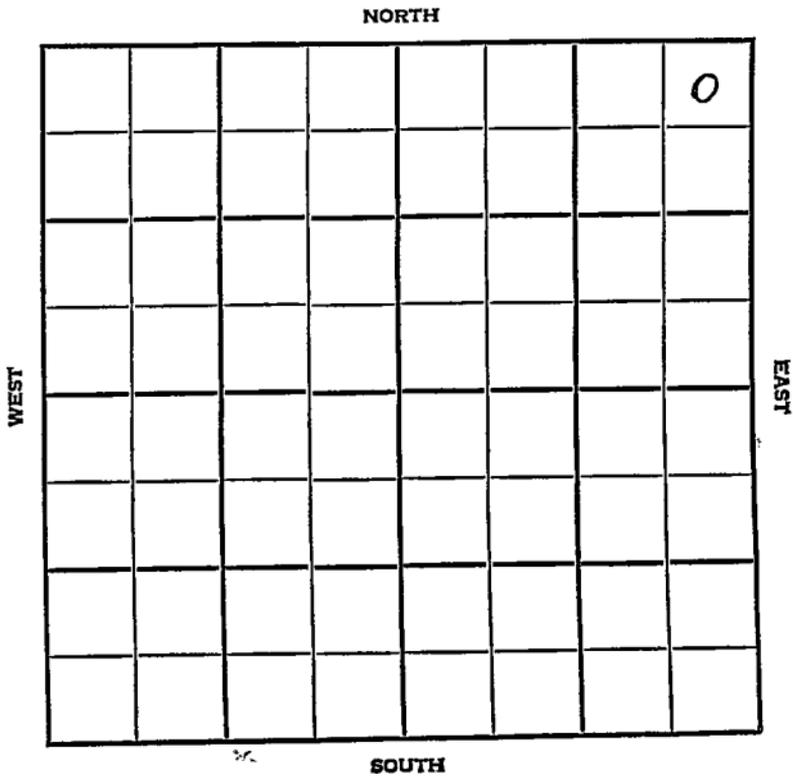

Graham

SEC.	TWP.	R.
10	8	25W

KANSAS


WELL NO. #1 Foltz FARM

COMPANY Empire Drlg.

CONTRACTOR Co. Tools.

Wildcat.

330 Ft. from N. Line
 Ft. from S. Line
 330 Ft. from E. Line
 Ft. from W. Line

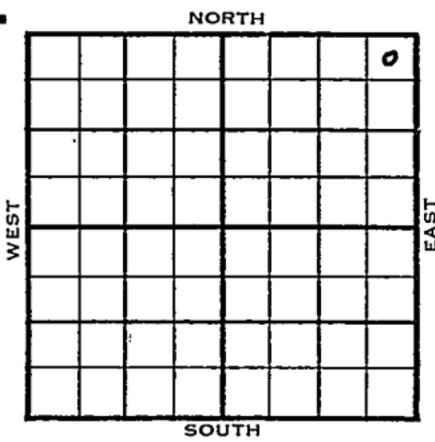

NE NE NE
 Sun - DHM

	ELEVATION	REPORT
1954	2422'	

10/11 Spud 11-8-54
 8" @ 167'
 WOC.

11/23 Spud 11-8-54 D & A TD 3980
 8" @ 167 Anhy 2162 Heeb 3708
 Lans. 3748
 DST 3768-95 open 1/2 hr. rec 8' VSOCM
 1000# B KC 3960 TD 3980
 D & A

ABANDONED

County Graham State Kansas

Sec. 10 (Blk. 8 (Sur. Rge.) 25W Map No.

Operator Empire Drlg.

Well No. 1 Farm Foltz

Elev. Location NE NE NE

									0

330 Ft. From N Line NE

330 Ft. From E Line Quarter

1st. Report NOV 10 1954

Completion

Remarks Sun - DEM

Co. tools

Spudding Date 11-8-54

Drlg. Data Wildcat

8" @ 167 WOC

FABEN GILSTRAD

