

Section 10 Township 8 Range 25 W


Well No. # 1 Walts

Company Wentworth Oil ~~Inc~~ & Development Co.

NORTH

WEST

EAST

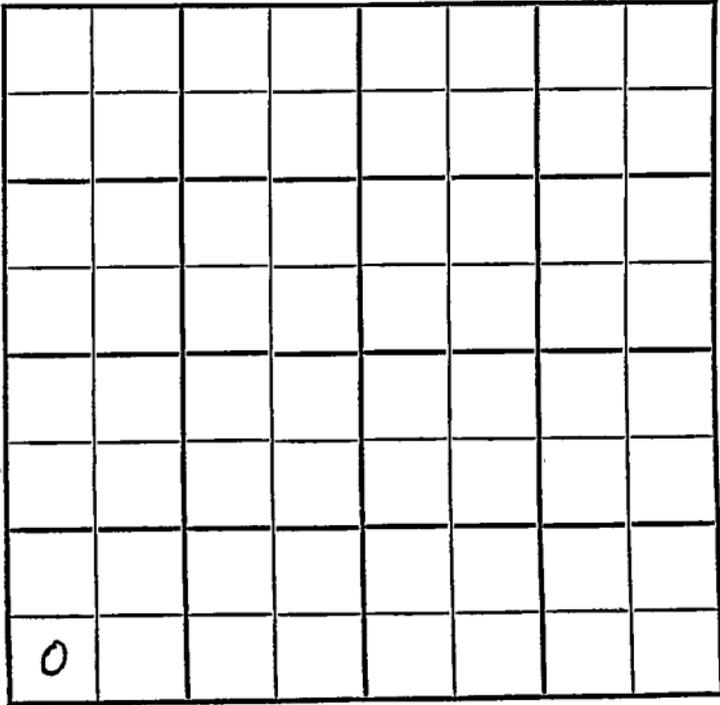

SOUTH

13

Graham KANSAS

SEC.	TWP.	R.
10	8	25 W

WELL NO. # 1 Walts FARM

COMPANY Wentworth Oil, Inc. + Development Co.

CONTRACTOR Co. tools

Wildcat


_____ Ft. from N. Line

330 _____ Ft. from S. Line

_____ Ft. from E. Line

330 _____ Ft. from W. Line

SW SW SW

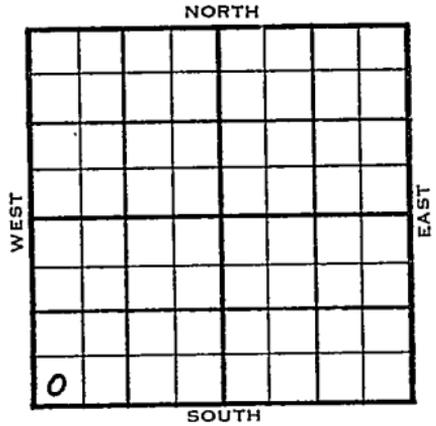

ELEVATION	REPORT
1954	2401'

8/11

MIR

10/6

Spud 8-13-54 - Oil Well

TD 3965'

8-5/8" @ 150'

Top 3472', Heeb 3681', Tor 3703',

Lans 3720', B KC 3936'

Schl Tops: Heeb 3676', Tor 3698',

Lans 3715', B KC 3931',

TD 3961'

5" @ 3944'

CO to 3965'

S/1/2 boph

PB 3880'

24/3867-72, F/5 boph, S/125 bo 24 hrs.

Comp. 175 bopd

COMPLETED

Map No. _____ Sec. 10 Twp. 8 R. 25W

Well No. 1 Walts

Wentworth Oil & Development Co. Company

CORRECTION

Contractor

SW SW SW

SECTION PLAT

_____ Ft. from N. Line

330 Ft. from S. Line

_____ Ft. from E. Line

330 Ft. from W. Line

o			

Graham County

Location _____

Rig up _____

Drilling and Remarks:

Reported
Wentworth Oil

RECORD

Cased _____ in., _____ ft.

Sand _____

Gas _____

Oil _____

Total Depth _____

PRODUCTION

1st 24 hrs. Nat. _____

1st 24 hrs. after shot _____

Gas _____ Cu. Ft.

Dry Hole _____

Abandoned _____

Date

Aug 18 1954

FABEN GILSTRAP Scout

County **Graham** State **Kansas**

Sec. **10** (Blk.) **8** (Sur.) **25W** Map No.

Operator **Wentworth Oil, Inc.**

Well No. **I** Farm **Walts**

Elev. Location **SW SW SW**

330Ft. From **S** Line **SW**

330Ft. From **W** Line Quarter

Ist. Report **AUG 11 1954**

Completion

Remarks

Co. tools

Spudding Date

Wildcat.

Drlg. Data **M I R**

