

DX 78-1


Graham

KANSAS

Section 10 Township 8 Range 25W

Well No. #2 Walts

Company Lee Wentworth

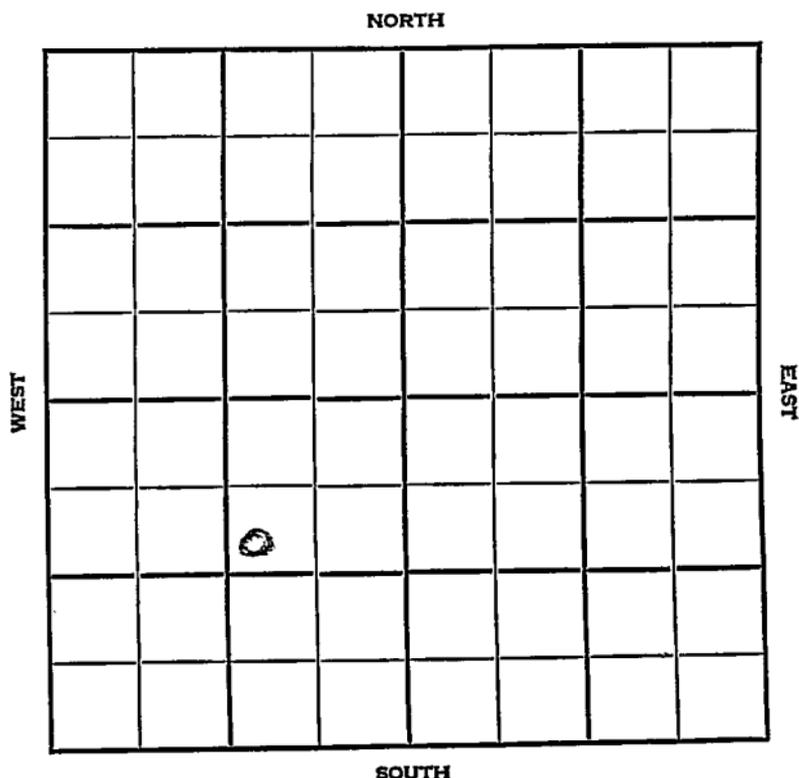

Graham

KANSAS

SEC.

10

TWP.

8

R.

25W

WELL NO.

2 Walts

FARM

COMPANY

Leo Wentworth

CONTRACTOR

Co. Tools


NE Schmied

\_\_\_\_\_ Ft. from N. Line

\_\_\_\_\_ Ft. from S. Line

\_\_\_\_\_ Ft. from E. Line

\_\_\_\_\_ Ft. from W. Line

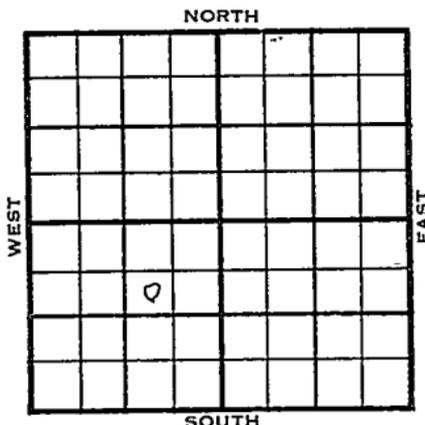

SW NE SW

	ELEVATION	REPORT
1955	2352	
5/26	Comm 5-13-55 8" @ 133	
	Cim. Anhy. 2083'	
	Drlg 2750	
8/3	Comm 5-13-55	
	Any 2083, H 3629, Tr 3654, KC 3668	
	8" @ 133 5 1/2" @ 3892/85 CO	
	20/3817-25 S/35 bopd 1500 A	
	S/41 boph 4 hr S/41 boph 24 hr.	
	Comp 103 bopd 6% wtr.	
	<b>COMPLETED</b>	

Twp. \_\_\_\_\_ Pool \_\_\_\_\_

Co. \_\_\_\_\_ Facet \_\_\_\_\_


FORM 513 REV. SUNRAY

# FIRST REPORT

County Graham / 1 Elev. \_\_\_\_\_ Co.  
 Sec. 10- Twp. 8 Rge. 25W  
 Company Leo Wentworth  
 Farm Name Walts No. 2

TOPS	DEPTH	DATUM
Cim. Anhydrite	2083	
Ft. Riley		
Howard		
Topeka		
Heebner Sh.		
Toronto Ls.		
Brown Lime		
Lansing		
Kans. City		
B. K. C.		
Congl.		
Miss.		
Kinderhook		
Misener		
Hunton		
Sylv. Maquo		
Viola		
Simpson		
Smp.		
Gorham		
Arbuckle		
Basal Sand		
Pre. Cam.		
T. D.		

Loc. in Section  
SW NE SW  
 Drlg. Contr. Co. tools  
 Pool NE Schmied

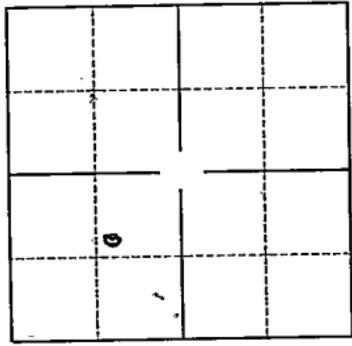

Date Comm. 5-13-55  
 Date Comp. \_\_\_\_\_

8" @ 133 drlg. 2750

Co.

Loc.

No.

S.

T.

R.

County Graham Elev. 2352  
 Sec. 10 Twp. 8 Rge. 25W  
 Company Leo Wentworth  
 FarmName Walts No. 2

TOPS	DEPTH	LOG	DATUM
Anh.	2083		
T.P.			
H.	3629		1277
Tr.	3654		1302
Dg.			
Bl.			
L.			
K.C.	3668		1316
B.K.C.			
Ce.			
C.			
M.			
M.			
K.			
Mz.			
Mq.			
V.			
S.			
S.			
A.			
R.			
P.E.			
G.			
T.P.	3920		

Loc. in Sec. SW NE SW  
 Geol. \_\_\_\_\_  
 Contr. Co. tools  
 Pool NE Schmied  
**COMPLETE**

Date Comm. 5-13-55 AUG 3 1955  
8" @ 133 5 1/2" @ 3892/85 CO  
20/ 3817-25 S/ 35 bopd 1500 A  
S/ 41 boph 4 hr. S/ 41 boph 24 hr.  
Comp. 103 bopd 6% wtr.

Co.

Lse.

No.

Sec.

T.

R.