


Section 10 Township 8 Range 24 W

Well No. # 4 Goff

Company Empire Drlg.

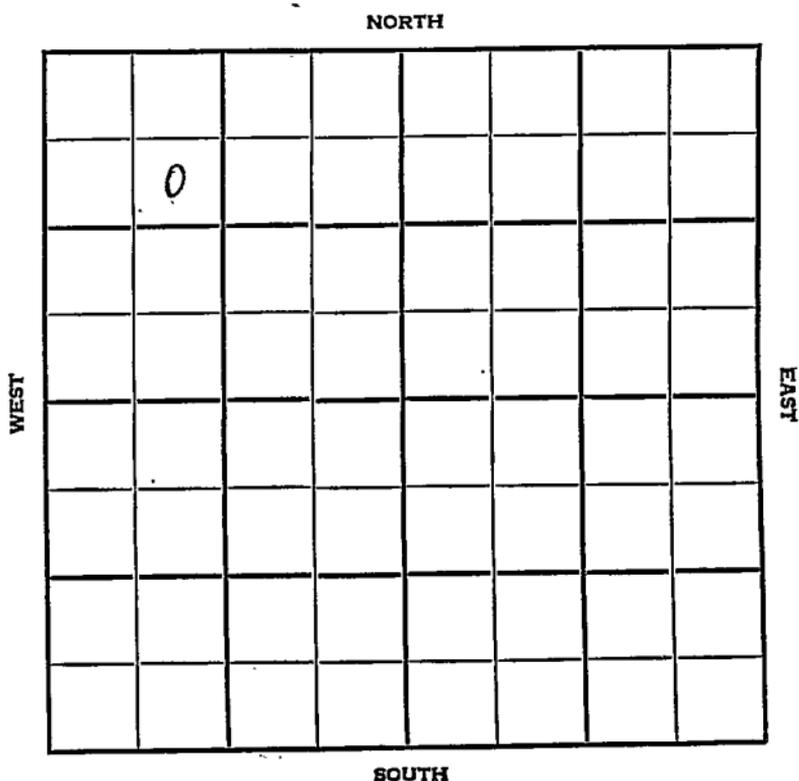

4

|      |      |     |
|------|------|-----|
| SEC. | TWP. | R.  |
| 10   | 8    | 24W |

WELL NO. #4 Goff FARM

COMPANY Empire Drlg.

CONTRACTOR

Nana Pool


990 Ft. from N. Line

Ft. from S. Line

Ft. from E. Line

990 Ft. from W. Line

SE NW NW

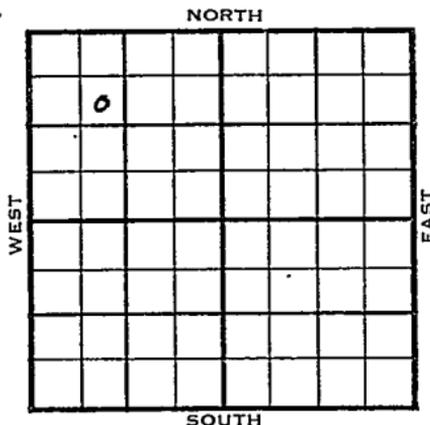

1954

ELEVATION 2282'

REPORT

9/15 Location

11/3

Oil Well  
 TD 3727' 8-5/8" @ 158'  
 Heeb 3500' 1/2 Tor 3517' Lans 3534'  
 DST 3600' -30' opn 1 hr, rec 5' Mud Off  
 TD 3727'  
 5" @ 3718'  
 CO to 3727'  
 28/ 3720-27 3000 A S/ 120 bo 10 hr.  
 Comp 149 bopd.

COMPLETED



