


Sheridan county

KANSAS

Section 10 Township 8 Range 29-W

Well No. #1, C. Thompson

Company Stanolind Oil and Gas Company

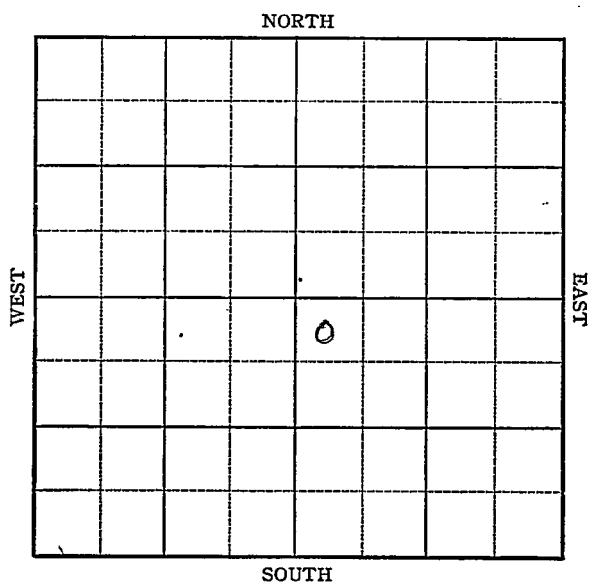

10

KANSAS

Sheridan

Sec. 10 Twp. 8 R. 29

Well No. #1 C. Thompson Farm
Stanolind Company


Wildcat

Ft. from N. Line

330 Ft. from S. Line

Ft. from E. Line

330 Ft. from W. Line

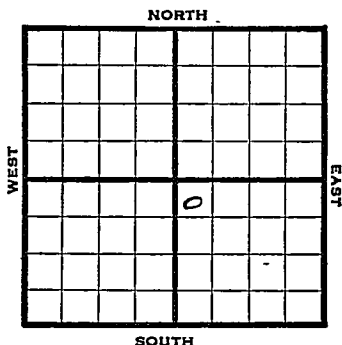

NW SE

1946

Elev. 2860'

REPORT

10/23 RUR
10/29 13" @ 150' WOC
11/6 Drlg 3350'
11/12 Drlg 4112'
11/20 Lans 3885'
Miss 4547'
Drlg 4570'
11/29 Arb 4694'
TD 4745',
SD
12/4 Arb 4694'
TD 4745'

ABANDONED

Wildcat

Form 26 200 Bks. 10-46 Petrol Kansas

KANSAS

Map No. _____ Sec. 10 Twp. 8 R. 29W

Well No. 1 C. Thompson

Stanolind

Company

FIRST REPORT

Contractor

NW SE

SECTION PLAT

		10	

_____ Ft. from N. Line

330 _____ Ft. from S. Line

_____ Ft. from E. Line

330 _____ Ft. from W. Line

Sheridan County

RECORD

Location _____

Cased _____ in., _____ ft.

Rig up _____

Sand _____

Drilling and Remarks:

Gas _____

R U R

Oil _____

Total Depth _____

PRODUCTION

1st 24 hrs. Nat. _____

1st 24 hrs. after shot _____

Gas _____ Cu. Ft.

Dry Hole _____

Abandoned _____

Date

OCT 23 1946

19

S. J. LEWIS

Scout

KANSAS
Kansas


Wildcat

Map No. _____ Sec. 10 Twp. 8 R. 29WWell No. 1 C. Thompson_____
Stanolind _____ Company

ABANDONED

Contractor

NW SE

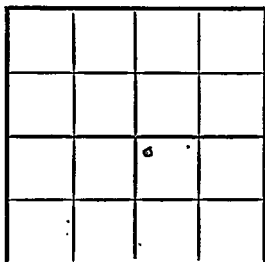E 1.2860
SECTION PLAT_____
Ft. from N. Line330 Ft. from S. Line_____
Ft. from E. Line330 Ft. from W. Line

Sheridan County

Location _____

Rig up _____

Drilling and Remarks:

Per Y4694

RECORD

Cased _____ in., _____ ft.

Sand _____

Gas _____

Oil _____

Total Depth 474.5

PRODUCTION

1st 24 hrs. Nat. _____

1st 24 hrs. after shot _____

Gas _____ Cu. Ft.

Dry Hole _____

Abandoned _____

Date

DEC 4 1946 19

S. J. LEWIS Scout