

KANSAS


Graham

Form 51-5M-7-40-Palace

Section 11 Township 8 Range 24W

Well No. #1 J.T.Paxtson

Company R.W.Shields

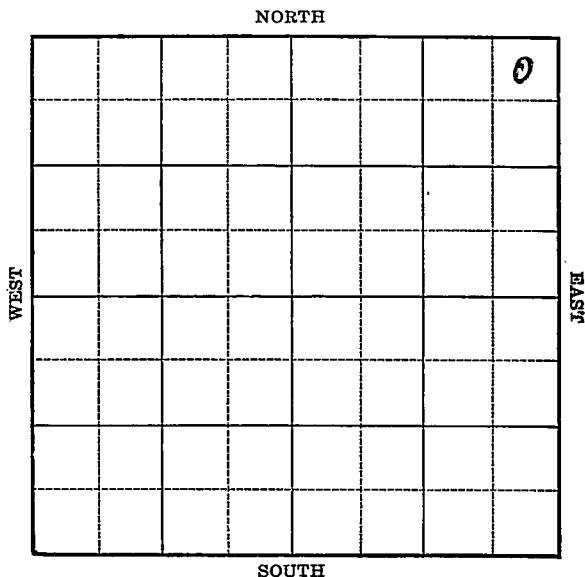

KANSAS


Graham

Sec. 11 Twp. 8 R. 24-WWell No. #1 J. T. Paxtson FarmR. W. Shields Company

(Wildcat)

330 Ft. from N. Line Ft. from S. Line330 Ft. from E. Line Ft. from W. Line

Elev. 2313

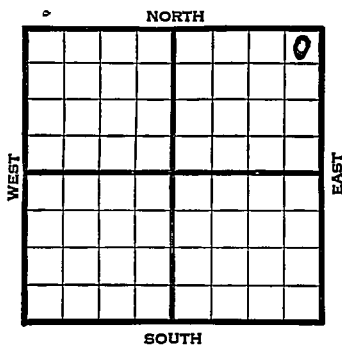

1940	REPORT
10/16	10" - 105'
	Drl g. 883'
10/24	Anhy 1945' Topeka 3184'
	Drl g. 3212'
10/31	Lans. 3558' Arb. 3965'
	Drl g. 4067'
11/7	T.D. 4104' 5" - 3823' cemented.
	P.B. 3771' 9 shots 3740-60'
	33 shots 3750-66 - 500 acid.
	1980' oil 4 hrs. 33.5 Gravity
11/14	Flow by heads. Run tubing.
11/21	Gravity 42.
11/27	" "
12/5	" "
12/12	Pump 12 bbls. in 4 hrs.
	43.2 Gravity
12/19	Shut down.
12/26	Pump 100 bbls. in 10 hours.
	Gas locked. Shut down.
1941	
1/2	" " " lil
1/9	" " " OVER

1941

1/16 Pump 100 bbls. in 10 hours.
Gas locked.
Shut down.

1/23	"	"
1/30	"	"
2/6	"	"
2/13	"	"
2/20	"	"
2/27	"	"
3/6	"	"

3/12 Lans. 3558'
Arb. 3965'
5" - 3823'
T.D. 4104'
P.B. to 3871'
9 shots 3740-60'
33 shots 3750-66'
500 acid.
Potential 216 bbls., pump.
42. Gravity

COMPLETED

Graham

KANSAS

Map No. 66 Sec. 11 Twp. 8 R. 24WWell No. 1 J. T. PaxtsonR. W. Shields

Company

Contractor

FIRST REPORT
NE/C**SECTION PLAT**

330 Ft. from N. Line Ft. from S. Line330 Ft. from E. Line Ft. from W. Line

WILDCAT

Location Rig up

Drilling and Remarks:

10" - 105Dr1g. 883**RECORD**Cased in., ft.Sand Gas Oil Total Depth **PRODUCTION**1st 24 hrs. Nat. 1st 24 hrs. after shot Gas Cu. Ft.Dry Hole Abandoned

Date

OCT 16 1940 19S. J. LEWIS

Scout

Form 26-200 Bks.—1-40—Palace Graham **KANSAS**

Map No. 66 Sec. 11 Twp. 8 R. 24W

Well No. 1 J. T. Paxon

R. W. Shields Company

Contractor

COMPLETED

NE/C

330 Ft. from N. Line

_____ Ft. from S. Line

330 Ft. from E. Line

_____ Ft. from W. Line

SECTION PLAT

			o

WILDCAT

Location _____

Rig up _____

Drilling and Remarks:

Lane. 3558

CR 3965

5" C 3823

• PB 3871. Mammation

9 Shot 3740-60

38 " 3758-66

500 acid

Pump 216 P.D.

420 Gr.

RECORD

Cased _____ in., _____ ft.

Sand _____

Gas _____

Oil _____

Total Depth 4104

PRODUCTION

1st 24 hrs. Nat. _____

1st 24 hrs. after shot _____

Gas _____ Cu. Ft.

Dry Hole _____

Abandoned _____

Date

MAR 12 1941 19

S. I. LEWIS Scout