

SECTION 11 TOWNSHIP 8 RANGE 27W

WELL NO. #1 Davis

COMPANY CRA & Aylward

NORTH

WEST

EAST

			0				

SOUTH

11

Sheridan

KANSAS

SEC.	TWP.	R.
11	8	27W


WELL NO. #1 Davis FARM

COMPANY CRA & Aylward

CONTRACTOR Aylward

WILDCAT

_____ Ft. from N. Line
 _____ Ft. from S. Line
 _____ Ft. from E. Line
 _____ Ft. from W. Line

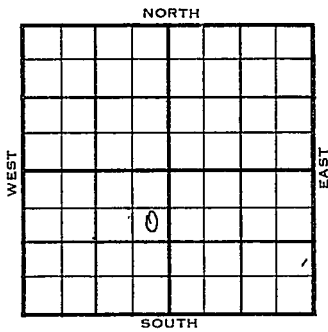

SE NE SW

Imperial - FO

1956	ELEVATION	REPORT
	2570'RB, 2567 DF	

5-2 Comm. 5-1-56
 5-16 8 5/8" @ 363 w/225
 DST 3782-3802 op 30 min. rec. 15' mdd
 1100/20"
 D & A
 Anh. 2233
 H. 3718 3716
 Tr. 3740 3742
 L. 3757 3757
 BKC 3974 3973
 TD 4000'

ABANDONED

County Sheridan Elev. _____
 Sec. 11 Twp. 8 Rge. 27W
 Company C/R A & Aylward
 Farm Name Davis No. 1

TOPS	DEPTH	LOG	DATUM	Loc. in Sec.
Anh.				SE NE SW
Tp.				
H.				
Tr.				
Dg.				
Bl.				
L.				Geol. _____
K.C.				Contr. _____
B.K.C.				<u>Aylward</u>
Ce.				Pool _____
C.				<u>Wildcat</u>
M.				
M.				
K.				
Mz.				
Ma.				
V.				
S.				
S.				
A.				
R.				
PE.				
G.				
T.D.				

FIRST REPORT			
MAY 2 '56			

Date Comm. 5-1-56 Imperial FO

2281 S. YAM

2.5

