

Sheridan


FORM 51

KANSAS

Section 11 Township 8 Range 30W

Well No. #2 B.E. Tilma

Company Vic Anderson

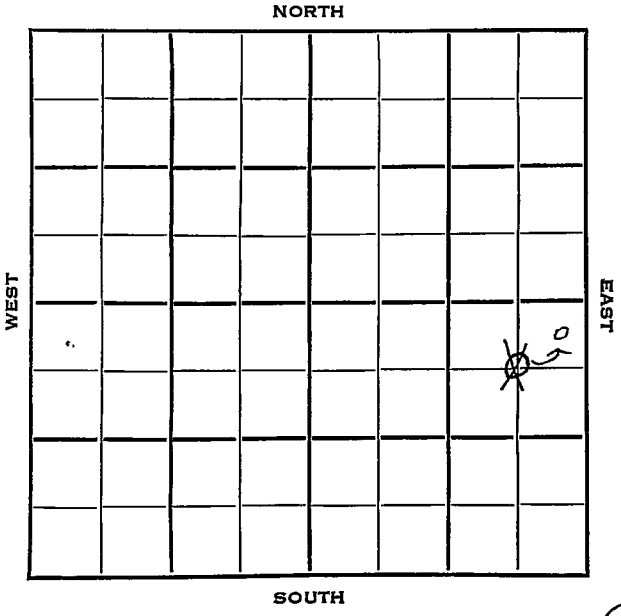

9

Sheridan

KANSAS

| | | |
|------|------|------|
| SEC. | TWP. | R. |
| 11 | 8 | 30 W |

WELL NO. # 2 B. E. ⁺Tilma FARM

COMPANY I

Vic Anderson

CONTRACTOR

Ehrlich


Wildcat

660 150 Ft. from N. Line

_____ Ft. from S. Line

660 150 Ft. from E. Line

_____ Ft. from W. Line

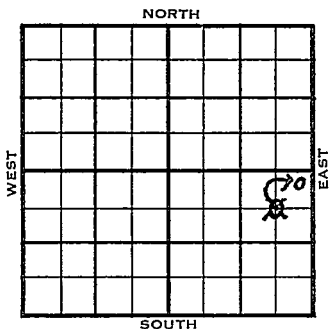

~~C NE SE~~
NE NE SE

| | ELEVATION | REPORT |
|------|-----------|--------|
| 1953 | 2931' | |

9/23 Spud 9-25-53

10/14 Drlg.

10/21 NR

10/28 NR

11/4 "

11/11 Spud 9-25-53
Abandoned Location

ABANDONED

Kansas

Map No. _____ Sec. 11 Twp. 8 R. 30WWell No. 2 Tilma

Vic Anderson _____ Company

CORRECTION _____ Contractor

NE NE SE

SECTION PLAT

150 Ft. from N. Line

_____ Ft. from S. Line

150 Ft. from E. Line

_____ Ft. from W. Line

| | | | |
|--|--|--|---|
| | | | |
| | | | |
| | | | o |
| | | | |

Sheridan County

Location _____

Rig up _____

Drilling and Remarks:

Reported

C, NE SE

RECORD

Cased _____ in., _____ ft.

Sand _____

Gas _____

Oil _____

Total Depth _____

PRODUCTION

1st 24 hrs. Nat. _____

1st 24 hrs. after shot _____

Gas _____ Cu. Ft.

Dry Hole _____

Abandoned _____

Date

OCT 7 1953

19

J. G. McGEHEE

Scout

