

Section 11 Township 8 Range 40 WWell No. # 1 Geo. RauckmanCompany Kingwood Oil

NORTH

							0

WEST

EAST

SOUTH

8

Sherman

KANSAS

Sec. 11 Twp. 8 R. 40 W

Well No. # 1 Geo. Rauckman Farm

Kingwood Oil Company

Contractor


 Ft. from N. Line

330 Ft. from S. Line

330 Ft. from E. Line

 Ft. from W. Line

SE SE NE

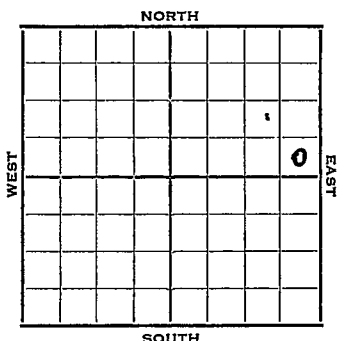

1952

Elev. 3707 REPORT

6/18 Location

6/25 RUR

7/2 Ft Hays 1670 Dakota 2100
Drlg. 2190

7/9 Morrison 2545 Anhy 2650
Drlg. 3673'

7/17 Ft. Riley 3712 Flournce Flint 3870
Topeka 4030
Drlg. 4500'

7/23 (Back dope DST 1280-1443' 15' m
140# DST 4096-4154' 1 hr.
120' OCM 850# 1 Drlg. 5062'

7/30 Drlg. 5403'

8/6 Schl. KTD 5573' 5" @ 4699'

8/13 CO 4653' 2/4610-10 $\frac{1}{2}$ dry
24/4624-30 fill up 600' SW 1 hr.
PB 5490 24/4542-48 dry 24/2548-54 dry
24/4513-19 dry 24/4519-25 S/ 7 BSW
1 hr. PB 4395 24/ 4364-70 dry
20/4325-30 S/ 1 $\frac{1}{2}$ Bswph PB 4166
2/4106-07 20/ 4095-4101 24/ 4114-20
B/5 galo & 20 galswph 500 A s/ 2-3/4
BO & 20 BW 10 hrs. Shot nitro 14095-4
4101 Shot nitro 4114-23 500 A
S/7 boph, est 1/2 BO Arb. 5462'

8/20 D & A

OVER

1952

8/20

Spud 6-25-52

D&A TD 5573

10" @ 318

Ft. Hays 1670 Dakota 2100

Morrison 2545 Anhy 2650

Ft. Riley 3712 Florence Flint 3870

Top 4030

DST 4144-84 opn $\frac{1}{2}$ hr. Rec. 30' mud
O#

DST 4191-4214 opn 1 hr. Rec. 285'
muddy sw 1100#

DST 1280-1443 Rec. 15' mud

140# DST 4096-4154 opn 1 hr.

Rec. 120' ocm 850# TD 5573

5" @ 4699 CO to 4653

2/4610-10 $\frac{1}{2}$ 24/4624-30

FU 600' sw 1 hr. PB 4590

24/4542-48 24/4548-54 24/4513-19

24/4519-25 S/7 bsw 1hr.

PB 4395 24/ 4364-70

20/4325-30 S/1 $\frac{1}{2}$ bswph PB 4166

2/4106-07 20/4095-4101

24/4114-20

B/5 go 20 gswph 500 A

S/2 e/4 bo 20 bw 10 hr.

Perf 4096-4101 4114-23 5000 A

S/7 bfph $\frac{1}{2}$ bo Arb. 5472

S/8 bo 42 bw 16 hr. S/8 bo 34 bwpd

Heeb. 4342 KC 4362 Marm 4705

Cherokee 5051 Miss 5183 Arb. 5472

Regan 5550' TL 5573

D&A

ABANDONED

Operator Kingwood Oil

Elev.	Location	SE	SP	ME
-------	----------	----	----	----

FIRST REPORT

330 Ft. From E Line Quarter

1st. Report **JUN 18 1952**

Completion


Remarks

Spudding Date

Drlg. Data

J. G. McGEHEE

County Sherman State Kansas
 Sec. 11 (Blk. 8) (Sur. 40W) Map No. Map No.
 Operator Kingwood Oil
 Well No. 1 Farm Geo. Rauckman
 Elev. 3707 Location SE SE NE

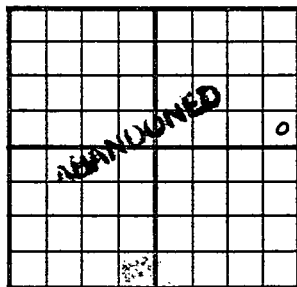

330 Ft. From S Line NE
330 Ft. From E Line Quarter

1st. Report

Completion ADG 2 0 1952

Remarks

Spudding Date 6-25-52

Drig. Data D & A TD 5573

10" @ 318 Ft. Hays 1670 Dakota 2100

Morrison 2545 Anhy. 2650 Ft. Riley 3712

Florence flint 3870 Top. 4030 DST 4144-

84 open $\frac{1}{2}$ hr. Rec. 30' mud 0#

DST 4191-4214 open 1 hr. Rec. 285' muddy

sw 1100# DST 1280-1443 Rec. 15' mud

140# DST 4096-4154 open 1 hr. Rec.

120'.ocm 850# TD 5573 .5" @ 4699

CO to 4653 2/ 4610-10 $\frac{1}{2}$ 24/ 4624-30

FU 600' sw 1 hr. PB 4590 24/ 4542-48

24/ 4548-54 24/ 4513-19 24/ 4519-25

S/ 7 bsw 1 hr. PB 4395 24/ 4364-70

20/ 4325-30 S/ 1 $\frac{1}{2}$ bswph PB 4166

2/ 4106-07 20/ 4096-4101 24/ 4114-20

J. G. McGEHEE

Drlg. Data

B/ 5 go 20 gswph 500 A S/ 2 3/4-bo
20 bw 10 hr. Perf/ 4096-4101 4114-23
5000 A S/ 7 bfph $\frac{1}{2}$ bo Arb. 5472
S/ 8 bo 42 bw 16 hr. S/ 8 bo 34 bwpd
Heeb. 4342 KC 4362 Marm. 4705
Cherokee 5051 Miss. 5183 Arb. 5472
Regan 5550 TD 5573

D & A

Scout Cards
Land Small Map
Land Wall Map
Tracings
France Map
Pierce Map
Misc.

SEP 2 1953