

Graham KANSAS

Section 12 Township 8 Range 23 W
Well No. # 1 Hill City
Company Ted Gore

				0			

NORTH

WEST

EAST

SOUTH

Sec. 12 Twp. 8 R. 23W

Well No. #1 Hill City Farm

Ted Gore Company

Wildcat Contractor


330' Ft. from N. Line

Ft. from S. Line

Ft. from E. Line

330' Ft. from W. Line

NW NW NE

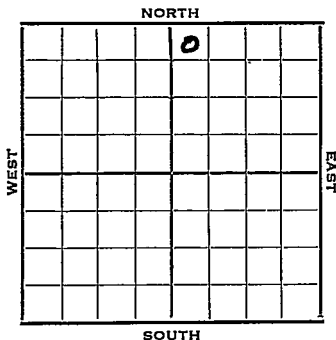

1952

Elev. 2208'

R E P O R T

9/17

8" @ 196

9/24

Anhy 1850' Topeka 3235' Heeb 3440'
Tor. 3463' Lans. 3477'
Dr1g. 3577'

10/1

Spud 9-15-52
D & A TD 3930' 8" @ 196 Anhy 1850'
Top 3235' Heeb 3440' Tor. 3463'
Lans. 3477' B KC 3659' Cong 3855'
Arb. 3894'
TD 3930' D & A

ABANDONED

County Graham State KansasSec. 12 (Blk.) 8 (Sur.) 23W Map No.Operator Ted GoreWell No. 1 Farm Hill CityElev. Location NW NW NE

FIRST REPORT

330 Ft. From N Line NE330 Ft. From W Line Quarter1st. Report SEP 17 1952

Completion

Remarks Derby \$ 2500.

Spudding Date

Drlg. Data Wildcat8" @ 196

J. G. McGEHEE

County Graham State KansasSec. 12 (Blk. Twp.) 8 (Sur. Rge.) 23W Map No. _____Operator Ted GoreWell No. 1 Farm Hill CityElev. 2208 Location NW NW NE

330 Ft. From N Line NE330 Ft. From W Line Quarter1st. ReportCompletion OCT 1 1952Remarks WildcatSpudding Date 9-15-52Drig. Data D & A TD 39308" @ 196 Anhy 1850 Top. 3235Heeb. 3440 Tor. 3463 Lans. 3477B KC 3659 Cong. 3855 Arb. 3894TD 3930D & A

J. G. McGEHEE