


Section 12 Township 8 Range 20W

Well No. #1 Gosselin

Company Deep Rock

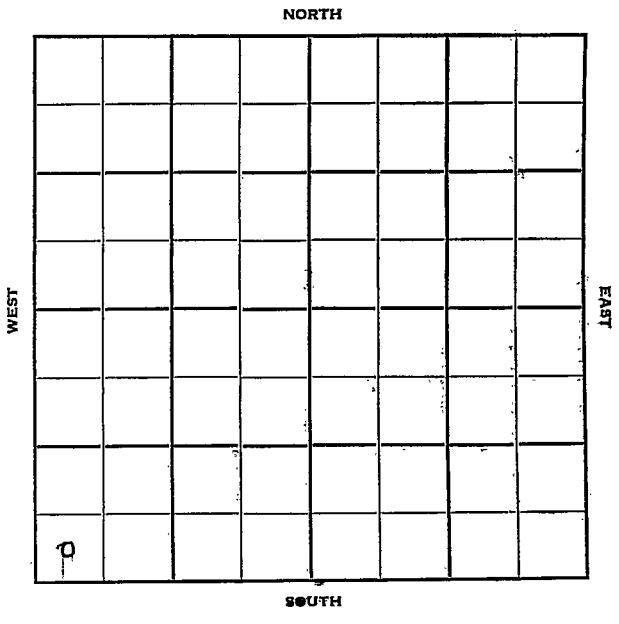

7 2 2000 30 10

100 1000

100 100

Sec. 12 Twp. 8 R. 20W

Well No. #1 Gosselin Farm

Deep Rock Company

Creekmore-Drlg. - Contr. Contractor

Wildcat


Ft. from N. Line

330' Ft. from S. Line

Ft. from E. Line

330' Ft. from W. Line

SW SW SW

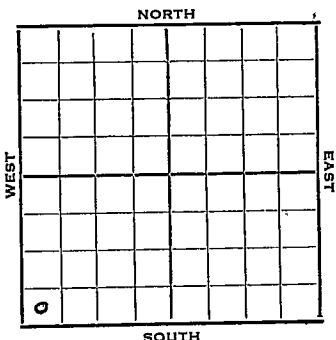

1951 Elev. 1997' REPORT

11/28 RUR

1952
1/23

Spud 11-28-51
Oil well TD 3492' 8" @ 113
Heeb 3151'
DST 3195-3221 open 1 hr. rec 385' oil
KC 3227'
DST 3288-3306 open 1 hr. rec 275' mud
300' sul. water.
DST 3414-41 open 1/2 hr. rec 10' mud
Arb. 3476-80 5" @ 3477 B KC 3436'
DD 3492' water PB 3450' 22/3428-36
S/1 GFPH 500 A B/10 GO 10 GWPH
PB 3245' 93/3204-14 S/2 BOPH
500 A S/4 BOPH
Comp. 55 BOPD 18% water.

COMPLETED

County Rooks State Kansas

Sec. 12 (Blk. Twp.) 8 (Sur. Rge.) 20W Map No.

Operator Deep Rock

Well No. 1 Farm Gosselin

Elev. _____ Location SW SW SW

FIRST REPORT			

330 Ft. From S Line SW

330 Ft. From W Line Quarter

1st. Report NOV 28 1951

Completion _____

Remarks _____

Creekmore Drig. - Contr.

Spudding Date _____

Drig. Data Wildcat

RUR

J. E. TYRA

