

Section 12 Township 8 Range 22WWell No. #1 DixonCompany Nadel Gussman

NORTH

0							

WEST

EAST

SOUTH

Graham

KANSAS

Sec. 12 Twp. 8 R. 22W

Well No. #1 Dixon Farm

Nadel & Gussman Company

Reserve Drlg. - Contr. Contractor

Wildcat


990' Ft. from N. Line

 Ft. from S. Line

 Ft. from E. Line

330' Ft. from W. Line

SW NW SW

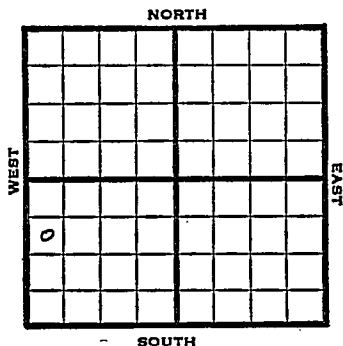

1950

Elev. 2048' REPORT

11/22

RUR

12/6

Spud 11-24-50

D&A TD 3653

13" @ 80 Heeb. 3238

Toronto 3258' Lans. 3276'


DST 3304-20 opn $\frac{1}{2}$ hr Rec. 80' mud

& wtr BKC 3492 Cong. 3548'

Arb. 3628 TD 3653

D&A

ABANDONED

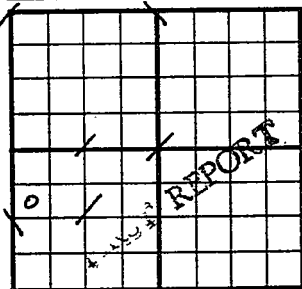County Graham State KansasSec. 12 (Blk.) 8 (Sur.) 22W Map No.Operator Nadel & GussmanWell No. 7 Farm DixonElev. _____ Location SW NW SW990 Ft. From N Line SW330 Ft. From W Line Quarter1st. Report NOV 22 1950

Completion _____

Remarks _____


Reserve Drlg. - Contr.

Spudding Date _____

Drlg. Data WildcatR U R

J. E. TYRA

County Graham State Kansas
 Sec. 12 (Blk. 8 (Sur. 22W Map No.)
 Operator Nadel & Gussman
 Well No. 1 Farm Dixon
 Elev. 2048 Location SW NW SW

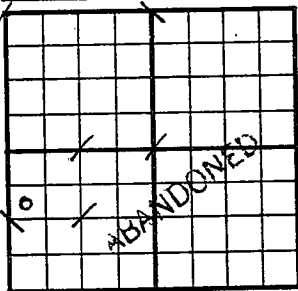

990 Ft. From N Line SW
330 Ft. From W Line Quarter

1st. Report

Completion DEC 6 1950

Remarks Wildcat

Reserve Drlg. - Contr.

Spudding Date 11-24-50

Drlg. Data D & A TD 3653

13" @ 80 Heeb. 3238 Toronto 3258

Lans. 3276 DST 3304-20 open $\frac{1}{2}$ hr.

Rec. 80' mud & water B KC 3492

Cong. 3548 Arb. 3628 TD 3653

D & A

J. E. TYRA