

KANSAS


Graham County

FORM 51 5M 11-44 PETROL

Section 13 Township 8 Range 22W

Well No. #1 P. Dorham

Company Stanolind.

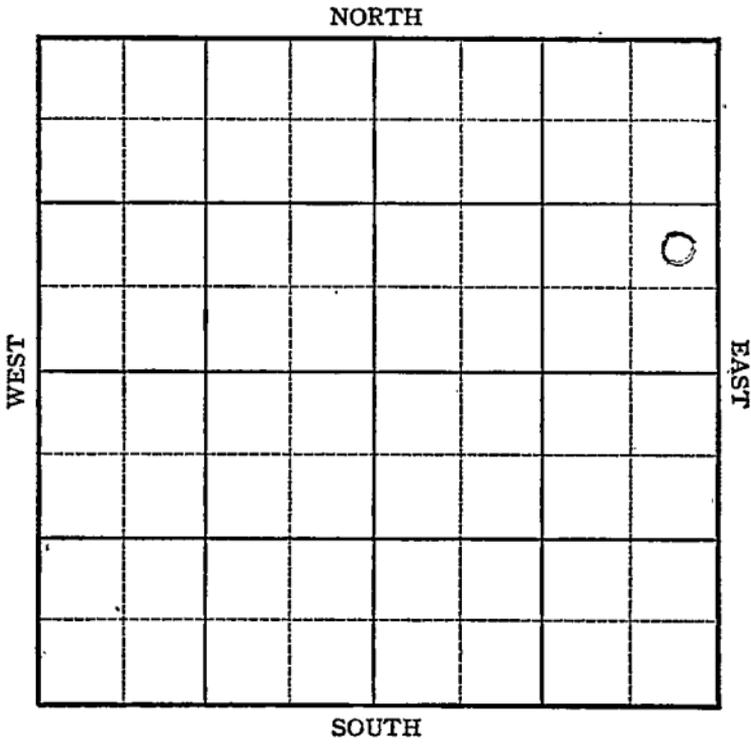

Sec. 13 Twp. 8S R. 22W

Well No. #1, P. Dorham Farm

Stanolind Company

NE SE NE


NORTH

 Ft. from N. Line

990 Ft. from S. Line

330 Ft. from E. Line

 Ft. from W. Line

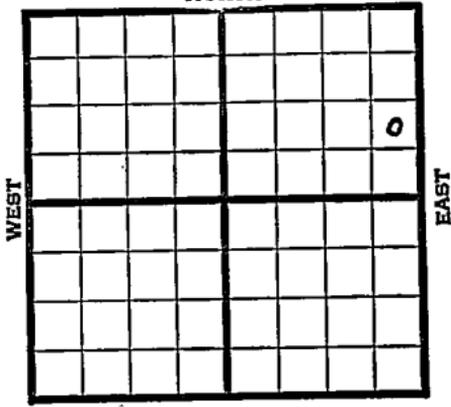

6 W. 2050

1945

REPORT

- 4-4 Rigging up rotary.
- 4/12 13" @ 188'
Drlg. 1465'
- 4/20 Anhy 3608
Topeka 3036
Drlg. 3280
- 4/26 Lans 3246
Cong 3593
Arb. 3644
TD 3721' S.D.
- 5/3 5" @ 3537 RUST
- 5/10 " " "
- 5/17 PB 3494
47 shots 3307-3315
 $\frac{1}{2}$ BW PH 500 acid.
- 5/24 PB 3292
35 shots 3271-3278 2500 acid.
Wtr. squeeze. Perf. WOC
- 6/6 Arb 3644
5" @ 3537
TD 3721

ABANDONED


Pool Name WildcatMap No. K66 Sec. 13 Twp. 8 R. 22WWell No. 1 P. DorhamStanolind Company

FIRST REPORT

Contractor

NE SE NE

SECTION PLAT

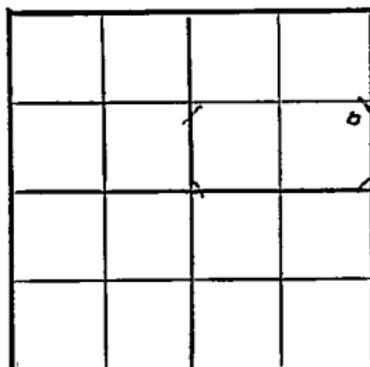

_____ Ft. from N. Line

990 Ft. from S. Line330 Ft. from E. Line

_____ Ft. from W. Line

Graham

Location _____

Rig up _____

Drilling and Remarks:

RUR

RECORD

Cased _____ in., _____ ft.

Sand _____

Gas _____

Oil _____

Total Depth _____

PRODUCTION

1st 24 hrs. Nat. _____

1st 24 hrs. after shot _____

Gas _____ Cu. Ft.

Dry Hole _____

Abandoned _____

Date

APR 4 1945 19 _____ S. J. LEWIS Scout

Kansas Pool Name WildcatMap No. 66 Sec. 13 Twp. 8 R. 22WWell No. 1 P. DorhamStanolind CompanyABANDONED Contractor

NE SE NE

E1,2050
SECTION PLAT

			o

_____ Ft. from N. Line

990 Ft. from S. Line330 Ft. from E. Line

_____ Ft. from W. Line

Graham County

Location _____

Rig up _____

Drilling and Remarks:

CR 836445 103537

RECORD

Cased _____ in., _____ ft.

Sand _____

Gas _____

Oil _____

Total Depth 3721'

PRODUCTION

1st 24 hrs. Nat. _____

1st 24 hrs. after shot _____

Gas _____ Cu. Ft.

Dry Hole _____

Abandoned _____

Date

JUN 6 1945 19S. J. LEWIS Scout