


SECTION 14 TOWNSHIP \_\_\_\_\_ RANGE 14W

WELL NO. #1 Bales

COMPANY Cities Service

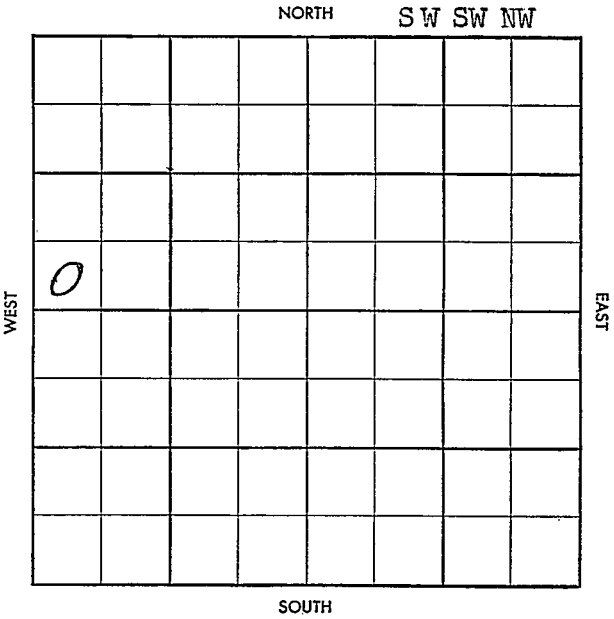

# WILDCAT

S-513-B

County Osborne Elev. \_\_\_\_\_  
 Sec. 14 Twp. 8 Rge. 1/W  
 Company Cities Service  
 Farm Name Bales No. 1

TOPS	DEPTH	LOG	DATUM
Anh.			
Tp.			
H.			
Tr.			
Dg.			
B.L.			
L.			
K.C.			
B.K.C.			
Ce.			
C.			
M.			
M.			
K.			
Mz.			
Mq.			
V.			
S.			
S.			
A.			
R.			
Pf.			
G.			
T.D.			

Loc. in Sec. \_\_\_\_\_  
SW SW NW  
455' SL  
 Geol. ~~X~~  
 Contr. \_\_\_\_\_  
 Pool Wildcat

**FIRST REPORT**  
 FEB 26 1956

Date Comm. \_\_\_\_\_

Location

Co.

Lse.

No.

Sec.

T.

R.

~~Top~~ ~~Pool~~  
~~Co.~~ ~~Facet~~

S-513-B 1

County Osborne Elev. 171  
 Sec. 14 Twp. 8 Rge. 1W  
 Company Cities Service  
 Farm Name Bales No. 1

TOPS	DEPTH	LOG	DATUM
Anh.	1030		
Tp. <u>Et Riley</u>	1767		
H.	3000	2971	
Tr.	3025		
Dg.			
B.L.			
L.	3052	3033	
K.C.			
B.K.C.	3360		
Ce.			
C.	3491		
M. <u>Chert C</u>	3548		
M. <u>Fros</u>	3595		
K. <u>M LI</u>	3660		
Mz.			
Mq.			
V.		3584	
S. <u>sh</u>		3716	
S.			
A.	3768	3767	
R.			
Pf.			
G.			
T.D.	3847	3844	

Loc. in Sec. \_\_\_\_\_  
SW SW NW  
455' SL  
 Geol. Wildcat  
 Contr. \_\_\_\_\_  
 Pool Wildcat

**ABANDONED**  
 0  
 APR 30 '58

Date Comm. 4-6-58

Location 8" 240/175 Woc APR 9 '58  
1768-80 1hr 10' M BHP 515/30" APR 16 '58 DST  
Circ. 3085 APR 23 '58 DST 3073-95  
1hr 12' M BHP 155/30 DST 3120-33  
1hr 110' M NB BHP DST 3467-3500  
1hr 20' M BHP 780/30 DST 3646-95  
1hr 20' M BHP 710/30 DST 3767 APR 30 '58

Log

D. & A