

KANSAS

Sec. 15 Twp. 8 R. 19W

Well No. #1 Burton Farm


Polhamus et al Company
Wildcat

330 Ft. from N. Line

 Ft. from S. Line

330 Ft. from E. Line

 Ft. from W. Line

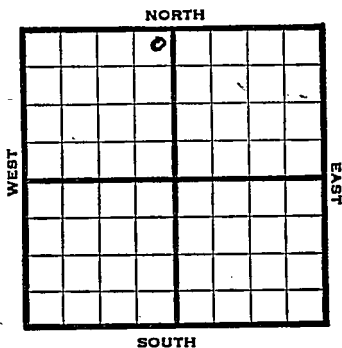

~~ENE~~ ~~NE~~ NW

1947

Elev. 1986' REPORT

10/8	Location
10/15	"
10/21	"
10/29	"
11/5	RUR
11/12	13" @ 88' Drlg. 2635'
11/19	Lans. 3183' Arb. 3451' TD 3523'

ABANDONED

Wildcat

Form 26 200 Bks. 10-46 Petrol
Kansas

Map No. _____ Sec. 15 Twp. 8 R. 19W

Well No. 1 Burton

Polhamus etal. Company

FIRST REPORT Contractor

NE NW


SECTION PLAT

330 Ft. from N. Line

_____ Ft. from S. Line

330 Ft. from E. Line

_____ Ft. from W. Line

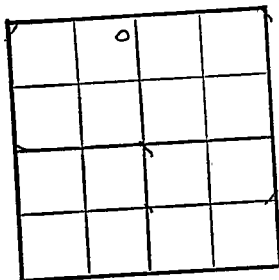

Rooks County

Location X

Rig up _____

Drilling and Remarks:

RECORD

Cased _____ in., _____ ft.

Sand _____

Gas _____

Oil _____

Total Depth _____

PRODUCTION

1st 24 hrs. Nat. _____

1st 24 hrs. after shot _____

Gas _____ Cu. Ft.

Dry Hole _____

Abandoned _____

Date

OCT 8 1947 19 _____

S. J. LEWIS

Scout

Wildcat

Form 26 200 Bks. 10-46 Petrol

Map No. 65 Kansas Sec. 15 Twp. 8 R. 19W

Well No. 1 Burton

Polhamus etal. Company

ABANDONED

Contractor

E. J. 1986

NE NW

SECTION PLAT

330 Ft. from N. Line

_____ Ft. from S. Line

330 Ft. from E. Line

_____ Ft. from W. Line

Rooks County

RECORD

Location _____

Cased _____ in., _____ ft.

Rig up _____

Sand _____

Drilling and Remarks:

Gas _____

Same 3183

Oil _____

Car 3451

Total Depth 1252.9

PRODUCTION

1st 24 hrs. Nat. _____

1st 24 hrs. after shot _____

Gas _____ Cu. Ft.

Dry Hole _____

Abandoned _____

Date

NOV 19 1947

S. J. LEWIS

Scout