

KANSAS

Rooks

Section 15 Township 8 Range 19WWell No. 1 BurtonCompany Brack Oil**Kriley**
NORTH

WEST

EAST

				0			

SOUTH

KANSAS

Rooks

Sec. 15 Twp. 8 R. 19W ✓

Well No. 1 Burton Farm

Brack Oil

Kriley (Brack, Cont.) Company

Pool


 Ft. from N. Line

330' Ft. from S. Line

 Ft. from E. Line

330' Ft. from W. Line

SW SE

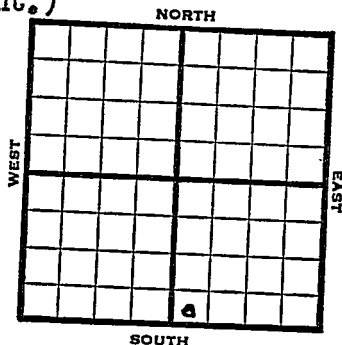

1949

Elev. 1959' REPORT

7/6
7/12
7/20

Location
8" @ 180'
Drlg 2610'
Lans 3154'
Cong. 3441'
TD 3467 in Cong.
ABANDONED

Kriley Pool

Map No. _____ Sec. 15 Twp. 8 R. 19W

Well No. 1 Burton

Brack Oil


Company _____

Brack

Contractor _____

SW SE

**FIRST REPORT
SECTION PLAT**

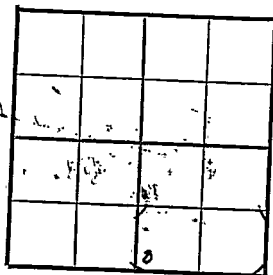

_____ Ft. from N. Line

330 Ft. from S. Line

_____ Ft. from E. Line

330 Ft. from W. Line

Rooks County

Location X

Rig up _____

Drilling and Remarks: _____

RECORD

Cased _____ in., _____ ft.

Sand _____

Gas _____

Oil _____

Total Depth _____

PRODUCTION

1st 24 hrs. Nat. _____

1st 24 hrs. after shot _____

Gas _____ Cu. Ft.

Dry Hole _____

Abandoned _____

Date

JUL 6 1949

19

S. J. LEWIS

Scout

Kansas

Kriley Pool

Map No. K 65 Sec. 15 Twp. 8 R. 19WWell No. 1 Burton

Brack Oil

Company

ABANDONED

Contractor

SW SE

E 11959

SECTION PLAT

Ft. from N. Line

330

Ft. from S. Line

Ft. from E. Line

330

Ft. from W. Line

Rooks County

RECORD

Location

Cased _____ in, _____ ft.

Rig up

Sand _____

Drilling and Remarks:

Gas _____

Lane 8154

Oil _____

Cong 8441

Total Depth 3467 in Cong

PRODUCTION

1st 24 hrs. Nat. _____

1st 24 hrs. after shot _____

Gas _____ Cu. Ft.

Dry Hole _____

Abandoned _____

Date

JUL 20 1949

19

S. J. LEWIS

Scout