


Rooke

Form 51-5M-11-31-Palace

Map No. **KANSAS** Sec. *15* Twp. *8* R. *19W*

Well No. *1 S. C. Stockton* Farm
Ashby & Sealy Company

NORTH

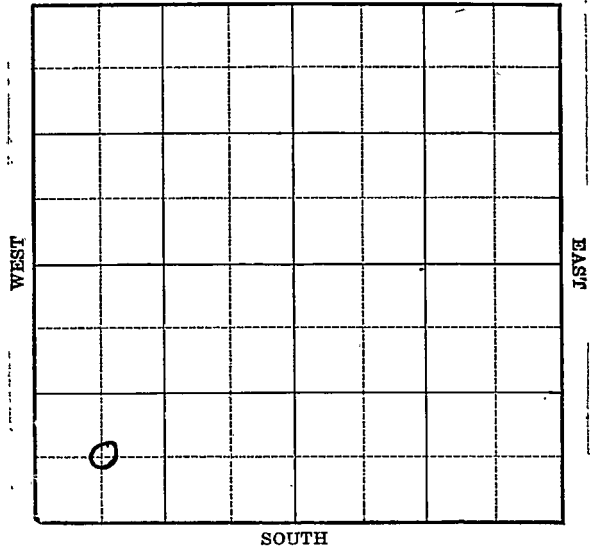

Location _____
Drilling Remarks _____

Rig Up _____
Drilling Remarks _____

RECORD

Cased _____ in. _____ ft.
Sand _____
Gas _____
Oil _____
Total Depth _____

PRODUCTION

1st 24 hrs. Nat. _____
1st 24 hrs. after shot _____
Gas _____ cu. ft. _____
Dry Hole _____
Abandoned _____

Rooke

KANSAS

Map No. _____ Sec. 15 Twp 8 R. 19

Well No. 1 S. C. Stockton Farm _____


Ashby & Seely Company _____

_____ Ft. from N. Line

660 Ft. from S. Line

_____ Ft. from E. Line

660 Ft. from W. Line

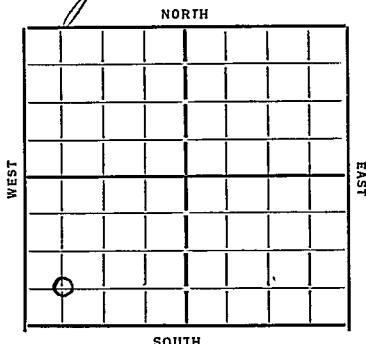

Date 7/24

REPORT

<u>1/31</u>	<u>Moving in Material</u>		
<u>2/9</u>	<u>—</u>		
<u>2/14</u>	<u>—</u>		
<u>2/23</u>	<u>—</u>		
<u>3/1</u>	<u>—</u>		
<u>3/8</u>	<u>—</u>		
<u>3/15</u>	<u>—</u>		
<u>3/22</u>	<u>Cellar</u>		
<u>3/29</u>	<u>Bldg Rig</u>		
<u>4/5</u>	<u>Spud</u>		
<u>4/12</u>	<u>—</u>	<u>4/19</u>	<u>—</u> <u>4/26</u> <u>—</u>
<u>5/3</u>	<u>—</u>	<u>5/10</u>	<u>—</u>
<u>5/18</u>	<u>dly 800</u>		
<u>5/25</u>	<u>" 925</u>		
<u>5/31</u>	<u>TD 925 7 sh took</u>		
<u>6/7</u>	<u>12 1/2 865 TD 900 W. R.</u>		
<u>6/14</u>	<u>W. R. 12 1/2" 1025.</u>		
<u>6/21</u>	<u>dly 1392</u>	<u>12" 1203</u>	
<u>6/28</u>	<u>" 1824</u>	<u>10" 1446</u>	
<u>7/5</u>	<u>" 2028</u>		
<u>7/12</u>	<u>—</u>		
<u>7/19</u>	<u>dly 2607</u>	<u>8" 2473</u>	

— OVER —

7/26 dly 2710

8/2 " 2760

8/9 9472 2815 6" 2823
dly 2958

8/16 6" 3106 TD 3130 W R 6"

8/23 6" 3165 Oswald 3186
Pay 3215-25 1700' oil 18 hrs.

8/30 Pump 3 Bbls per hr
Treat 1000 acid No test

9/6 Pump 210 Bbls 14 hrs.

9/13 Taking potential

9/19 Oswald 3186
Oil 3215-25 TD 3225
1000 acid
264 oil 24 water

COMPLETED

Map No. 65 Sec. 15 Twp. 8 R. 19W

Well No. 1- S. C. Stockton

Ashby & Sealy Company

Contractor

FIRST REPORTS

Ft. from N. Line

660 Ft. from S. Line

Ft. from E. Line

660 Ft. from W. Line

SECTION PLAT

0			

Location.....

Rig up.....

Drilling and Remarks:

*Moving in
material*

RECORD

Cased.....in.,ft.

Sand.....

Gas.....

Oil.....

Total Depth.....

PRODUCTION

1st 24 hrs. Nat.....

1st 24 hrs. after shot.....

Gas.....Cu. Ft.

Dry Hole.....

Abandoned.....

Date

1-31-34 192 O. Manschreck Scout

Map No. 65 Sec. 15 Twp. 8 R. 19W

Well No. 1-A. C. Stockton

Ashby & Sealy Company

Contractor

COMPLETED

SECTION PLAT

0			

Ft. from N. Line

660 Ft. from S. Line

Ft. from E. Line

660 Ft. from W. Line

Location.....

Rig up.....

Drilling and Remarks:

1000 and

264 oil
24 water

RECORD

Cased.....in.ft.

Sand Oswald 3186

Gas.....

Oil 3215-25

Total Depth 3225

PRODUCTION

1st 24 hrs. Nat.....

1st 24 hrs. after shot.....

Gas.....Cu. Ft.

Dry Hole.....

Abandoned.....

Date

9-19-31 192

ORVAL MANNSCHRECK

Scout