FORM 51 10M 8-47

Osborne


KANSAS

Section 15 - Township 8 Range 14-W

Well No. #1 Spier

Company Westgate-Greenland

Wildcat

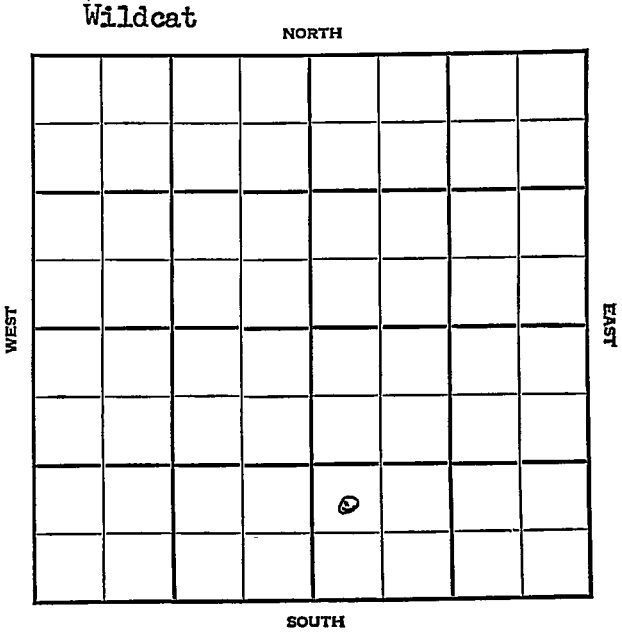

FORM 252-A
5M 4-48 PETROL

KANSAS

Osborne

Sec. 15 Twp. 8 R. 14W

Well No. #1 ~~Newschwanger~~ Spier Farm

Westgate-Greenland Company

Wildcat


_____ Ft. from N. Line

990' Ft. from S. Line

_____ Ft. from E. Line

330' Ft. from W. Line

- NW - SW SE

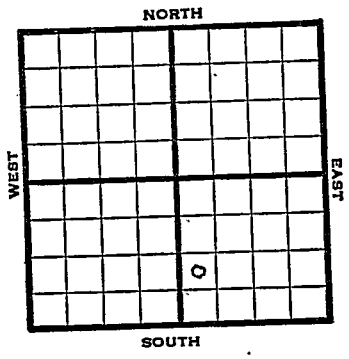

1948	Elev. 1888' REPORT
5/26	RUR
6/1	8" @ 150' Lansing 3092' TD 3122' 5" @ 3112' RUST
6/9	DST 3102-22 Rec used some free Oil
6/16	"
6/23	TD 3126- 500 acid SSO 96 shots 3112-24 - 500 acid 126 shots 3092-3114 3000 acid Swb 2 bbls oil a day
6/30	Lans. 3092' TD 3126' ABANDONED

Form 26—200 Bks.—1-48—Palace

Wildcat

Kansas

Map No. _____ Sec. 15 Twp. 8 R. 14W

Well No. 1 Newschwanger


Westgate-Greenland Company

FIRST REPORT

Contractor

NW SW SE

SECTION PLAT

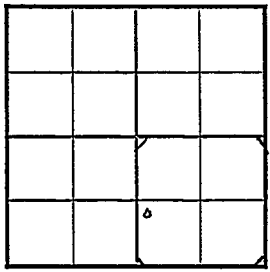

_____ Ft. from N. Line

990 Ft. from S. Line

_____ Ft. from E. Line

330 Ft. from W. Line

Osborne County

Location _____

Rig up _____

Drilling and Remarks:

R U R

RECORD

Cased _____ in., _____ ft.

Sand _____

Gas _____

Oil _____

Total Depth _____

PRODUCTION

1st 24 hrs. Nat. _____

1st 24 hrs. after shot _____

Gas _____ Cu. Ft.

Dry Hole _____

Abandoned _____

Date

MAY 26 1948 19____ S. J. LEWIS Scout

Form 26—200 Bks.—1-48—Palace

Wildcat

Kansas

Map No. 63 Sec. 15 Twp. 8 R. 14W

Well No. 1 Spier


Westgate-Greenland Company

CORRECTION

Contractor

NW SW SE

SECTION PLAT

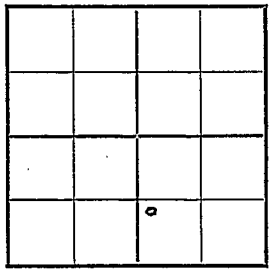

____ Ft. from N. Line

990 Ft. from S. Line

____ Ft. from E. Line

330 Ft. from W. Line

Osborne County

Location

Rig up

Drilling and Remarks:

Reported as
#1 Newschwanger

RECORD

Cased ____ in., ____ ft.

Sand

Gas

Oil

Total Depth

PRODUCTION

1st 24 hrs. Nat.

1st 24 hrs. after shot

Gas ____ Cu. Ft.

Dry Hole

Abandoned

Date

JUN 1 1948 19

S. J. LEWIS Scout

Form 26—200 Bks.—1-48—Palace

Wildcat

Kansas

Map No. 63 Sec. 15 Twp. 8 R. 14W

Well No. 1 Spear


Westgate-Greenland Company

ABANDONED Contractor

NW SW SE

E.L. 1888'

SECTION PLAT

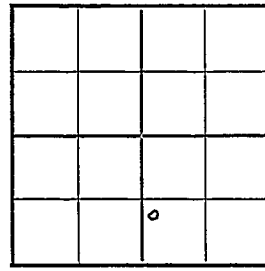

____ Ft. from N. Line

990 Ft. from S. Line

____ Ft. from E. Line

330 Ft. from W. Line

Osborne County

Location

Rig up

Drilling and Remarks:

Lans 8092

RECORD

Cased ____ in., ____ ft.

Sand

Gas

Oil

Total Depth 3126

PRODUCTION

1st 24 hrs. Nat.

1st 24 hrs. after shot

Gas ____ Cu. Ft.

Dry Hole

Abandoned

Date

JUN 30 1948 19____ S. J. LEWIS Scout