

KANSAS

Company Westgate-Greenland

NORTH

WEST

EAST

SOUTH

KANSAS

Osborne

Sec. 15 Twp. 8 R. 14W

Well No. #2 Spear Farm

Westgate-Greenland

Company

Wildcat


Ft. from N. Line

330' Ft. from S. Line

990' Ft. from E. Line

Ft. from W. Line

SW SE NW

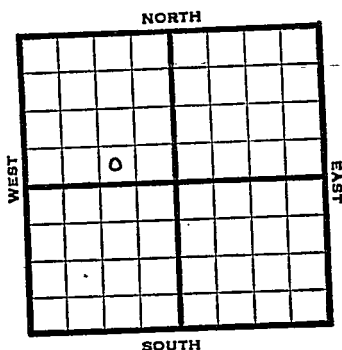

1948

Elev. 1879' REPORT

7/8

Location

7/14

8" @ 260'

7/21

Drilg 2045'

7/28

Drilg 2820'

Lansing 3086'

TD 3092'

5" @ 3092'

8/4

"

8/11

Lans 3086'

5" @ 3092'

TD 3165'

ABANDONED

Map No. _____ Sec. 15 Twp. 8 R. 14W

Well No. 2 Spear

Westgate-Greenland Company

FIRST REPORT

Contractor

SW SE NW

SECTION PLAT

_____ Ft. from N. Line

330 Ft. from S. Line

990 Ft. from E. Line

_____ Ft. from W. Line

Osborne County

Location X

Rig up _____

Drilling and Remarks:

RECORD

Cased _____ in., _____ ft.

Sand _____

Gas _____

Oil _____

Total Depth _____

PRODUCTION

1st 24 hrs. Nat. _____

1st 24 hrs. after shot _____

Gas _____ Cu. Ft.

Dry Hole _____

Abandoned _____

Date

JUL 8 1948 19 S. J. LEWIS Scout

Osborne County Kansas State

Map No. 63 Sec. 15 Twp. 8 R. 14W

Well No. 2 Spear


Westgate-Greenland Company

ABANDONED

Contractor

SW SE NW

E. 1879
SECTION PLAT

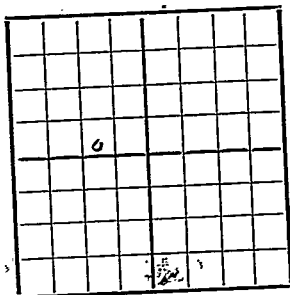

 Ft. from N. Line

330 Ft. from S. Line

990 Ft. from E. Line

 Ft. from W. Line

Wildcat

Remarks:

Law 3086

5" @ 3092

YD 2165

Date

AUG 11 1948

Scout

S. J. LEWIS