


Section 15 Township 8 Range 25 W

Well No. #1 Morland

Company Jones, Shelburne & Farmer

NORTH

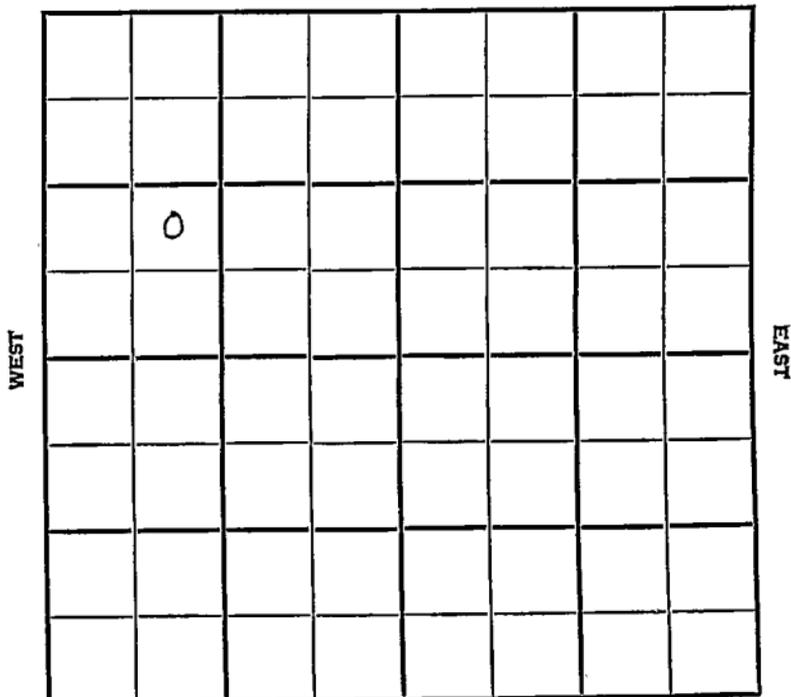

SOUTH

5

SEC.	TWP.	R.
15	8	25W

WELL NO.

#1 Morland

FARM

COMPANY

Jones, Shelburne &amp; Farmer

CONTRACTOR

Co. Tools

Schmeid


\_\_\_\_\_ Ft. from N. Line

\_\_\_\_\_ Ft. from S. Line

\_\_\_\_\_ Ft. from E. Line

\_\_\_\_\_ Ft. from W. Line

NE SW NW

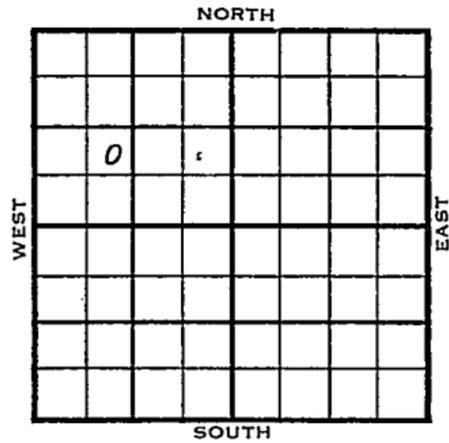

1955	ELEVATION 2380	REPORT
------	-------------------	--------

7/20

Comm 7-22-55

8" @ 125/115

Drlg 3180

8/3

Comm 7-22-55

Tp 3452, H 3642, Tr 3667, L 3681,

BKC 3905

8" @ 125/115

DST 3716-41 open 1/2 hr Rec 35' mud

1210/20" DST 3804-45 open 1/2 hr

Rec 30' mud 460/20" TD 3920

D &amp; A

**ABANDONED**

County Graham Elev. \_\_\_\_\_  
 Sec. 15 Twp. 8 Rge. 25W  
 Company Jones, Shelburne & Farmer  
 Farm Name Morland No. 1

TOPS	DEPTH	LOG	DATUM
Anh.			
Tr.			
H.			
Tr.			
Dg.			
Bl.			
L.			
K.C.			
B.K.C.			
Ce.			
C.			
M.			
M.			
K.			
Mz.			
Ma.			
V.			
S.			
S.			
A.			
R.			
PE.			
G.			
T.D.			

Loc. in Sec. NE SW NW  
 Geol. \_\_\_\_\_  
 Contr. \_\_\_\_\_  
 Co. tools \_\_\_\_\_  
 Pool Schmeid

FIRST REPORT  
 JUL 27 55

Date Comm. 7-22-55  
8" @ 125/115 drlg. 3180

*[Handwritten signature]*

Co.  
 Use.  
 No.  
 Sec.  
 T.  
 R.

County Graham Elev. 2380  
 Sec. 15 Twp. 8 Rge. 25W  
 Company Jones, Shelburne & Farmer  
 FarmName Morland No. 1

TOPS	DEPTH	LOG	DATUM
Anh.			
TP.	3452		1072
H.	3642		1262
Tr.	3667		1287
Dg.			
BL.			
L.	3681		1301
K.C.			
B.K.C.	3905		1525
Ce.			
C.			
M.			
M.			
K.			
Mz.			
Mq.			
V.			
S.			
S.			
A.			
R.			
Pe.			
G.			
T.D.	3920		

Loc. in Sec. NE SW NW  
 Geol. \_\_\_\_\_  
 Contr. \_\_\_\_\_  
 Co. tools \_\_\_\_\_  
 Pool Schmeid



Date Comm. 7-22-55 AUG 3 1955

8" @ 125/115 .. DST 3716-41 .. open 1/2 hr.  
 Rec. 35' mud 1210/20" .. DST 3804-45  
 open 1/2 hr. Rec. 30' mud 460/20"

TD 3920  
 D & A

Co.  
 Use.  
 No.  
 Sec.  
 T.  
 R.