

Section 15 Township 8 S Range 25 WWell No. # 1 Lunney "B"Company Don Pratt & Empire Drlg.

NORTH

WEST

0							

EAST

SOUTH

12

Graham KANSAS

SEC.	TWP.	R.
15	8S	25W

WELL NO.

1 Lunney #B

FARM

COMPANY

Don Pratt & Empire Drlg.

CONTRACTOR


Empire Tools
Schmeid

330 Ft. from N. Line

Ft. from S. Line

Ft. from E. Line

330 Ft. from W. Line

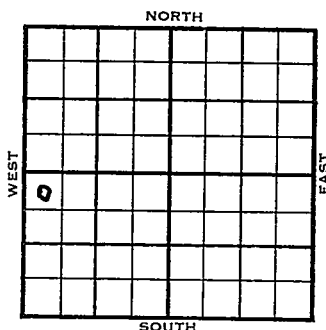

NW NW SW

	ELEVATION	REPORT
1954	2331'	

12/8 Spud 12-6-54
8" @ 168', WOC

12/22 Spud 12-6-54
D & A
TD 3885'
8" @ 168'
Anhy 2058', Heeb 3604' Tor 3627'
KC. 3641'
DST 3680'-3705' opn $\frac{1}{2}$ hr, rec 12' Mud
825#
DST 3788'-3815' opn $\frac{1}{2}$ hr, rec 10' Mud
170# B KC 3861',
TD 3885'
D & A

ABANDONED

County Graham State Kansas

Sec. 15 (Blk. Twp.) BS (Sur. Rge.) 25W Map No.

Operator Don Pratt & Empire Drig

Well No. **1** Farm **Lunney "B"**

Elev.	Location	NW	NW	SW
-------	----------	----	----	----

0
FIRST REPORT

330 Ft. From N Line

330 Ft. From W Line SW Quarter

1st. Report DEC 8 1954.

Completion _____

Remarks Empire tools

Spudding Date 12-6-54

Drlg. Data - Schmeid

Rⁿ @ 168 WCC

FABEN GILSTRAP

County	Graham		State	Kansas	
Sec.	15	(Blk.) (Twp.)	8	(Sur.) (Rge.)	25W Map No.
Operator	Don Pratt & Empire Drlg.				
Well No.	1	Farm	Lunney "B"		
Elev.	2331	Location	NW NW SW		

0

ABANDONED

330 Ft. From	N Line	SW
330 Ft. From	W Line	Quarter

1st. Report

Completion DFC 2 2 1954

Remarks Schmeid Pool

Empire Drlg. - Contr.

Spudding Date 12-6-54

Drig. Data D & A TD 3885

8" @ 168 Anhy 2058 Heeb. 3604

- Tor. 3627 KC 3641 DST 3680-3705

open $\frac{1}{2}$ hr. Rec. 12' mud 825#

DST 3788-3815 open $\frac{1}{2}$ hr. Rec. 10' mud
170# B KC 3861 TD 3885

D & A

FABEN C' LTDAP