


Sheridan

Section 15 Township 8 Range 26W

Well No. #1 Twell

Company Imperial Drlg

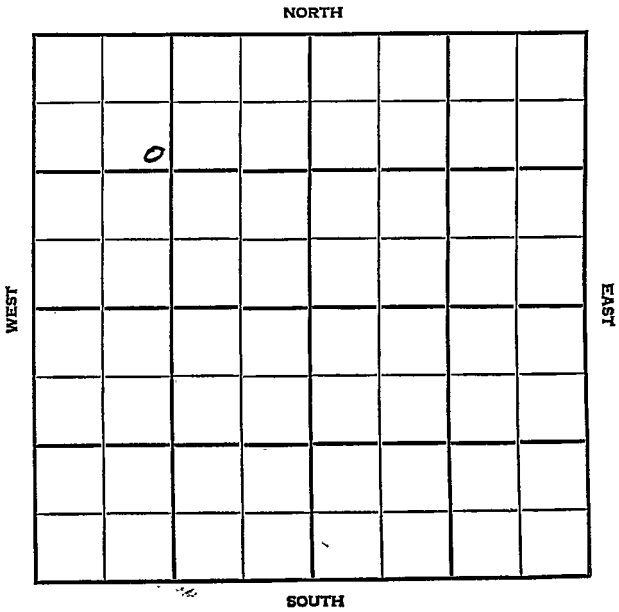

SEC.	TWP.	R.
15	8	26 W

WELL NO. # 1 Twell FARM

COMPANY Imperial Drlg.

CONTRACTOR

Wildcat


\_\_\_\_\_ Ft. from N. Line

\_\_\_\_\_ Ft. from S. Line

\_\_\_\_\_ Ft. from E. Line

\_\_\_\_\_ Ft. from W. Line

SE NW NW

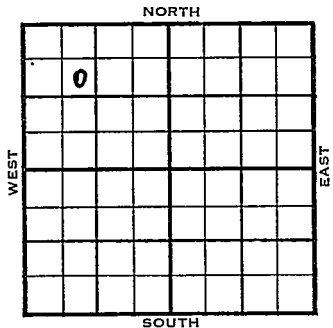

ELEVATION	REPORT
-----------	--------

1955	
6/8	Location	
7/7	Spud 6-11-55, 8 5/8" - @228/175 DST 3762 -80 open 1 hr. Rec 20' mud 1180/20" DST 3791-3813 open 1 hr. Rec. 6' mud 6/20" DS 3819-34 open 1/2 hr. rec 7' mud 0/20" DS† 4187-4217 open 1/2 hr Rec 40' 1120#. D&A	
	<table border="1"> <thead> <tr> <th>Tops:</th> <th>Depth</th> <th>Log</th> <th>Datum</th> </tr> </thead> <tbody> <tr> <td>Anh</td> <td>2080</td> <td>2080</td> <td></td> </tr> <tr> <td>H.</td> <td>3605</td> <td>3604</td> <td>1157</td> </tr> <tr> <td>Tr.</td> <td>3627</td> <td>3625</td> <td>1178</td> </tr> <tr> <td>L.</td> <td>3641</td> <td>3645</td> <td>1198</td> </tr> <tr> <td>BKC</td> <td>3860</td> <td>3860</td> <td>1413</td> </tr> <tr> <td>M. Ch.</td> <td>4183</td> <td>4183</td> <td>1736</td> </tr> <tr> <td>Mz Gil Gity</td> <td></td> <td>4263</td> <td>1816</td> </tr> <tr> <td>V.</td> <td>4302</td> <td>4302</td> <td>1855</td> </tr> <tr> <td>A.</td> <td>4399</td> <td>4399</td> <td>1952</td> </tr> <tr> <td>TD</td> <td>4450</td> <td>4450</td> <td></td> </tr> </tbody> </table>	Tops:	Depth	Log	Datum	Anh	2080	2080		H.	3605	3604	1157	Tr.	3627	3625	1178	L.	3641	3645	1198	BKC	3860	3860	1413	M. Ch.	4183	4183	1736	Mz Gil Gity		4263	1816	V.	4302	4302	1855	A.	4399	4399	1952	TD	4450	4450	
Tops:	Depth	Log	Datum	
Anh	2080	2080	
H.	3605	3604	1157	
Tr.	3627	3625	1178	
L.	3641	3645	1198	
BKC	3860	3860	1413	
M. Ch.	4183	4183	1736	
Mz Gil Gity		4263	1816	
V.	4302	4302	1855	
A.	4399	4399	1952	
TD	4450	4450	

ABANDONED



2444 DF  
2447 RB

County Sheridan Elev. \_\_\_\_\_  
 Sec. 15 Twp. 8 Rge. 26W  
 Company Imperial Drlg.  
 Farm Name Twell No. 1

	TOPS	DEPTH	LOG	DATUM
Anh.		2080	2080	
Ip.				
H.		3605	3604	1157
Tr.		3627	3625	1178
Dg.				
Bl.				
L.		3641	3645	1198
K.C.				
B.K.C.		3860	3860	1413
Ce.				
C.				
M.	Cb	4183	4183	1736
M.	Lm	4229	4222	1775
K.				
Mz.	Gil City		4263	1816
Me.				
V.		4302	4302	1855
S.				
S.				
A.		4399	4399	1952
R.				
PE.				
G.				
T.D.		4450	4450	

Loc. in Sec. \_\_\_\_\_  
 SE NW NW  
 850' WI  
 Geol. \_\_\_\_\_  
 Contr \_\_\_\_\_  
 Co. tools \_\_\_\_\_  
 Pool \_\_\_\_\_  
 Wildcat

o		

**ABANDONED**

Date Comm. 6-11-55 JUL 6 1955  
8 5/8" @ 228/175 DST 3762-80  
open 1 hr. Rec. 20' mud 1180/20"  
DST 3791-3813 open 1 hr. Rec. 6' mud  
0/20" DST 3819-34 open 1/2 hr. rec.  
7' mud 0/20" DST 4187-4217 open 1/2 hr.  
Rec. 40' mud 1120#

D & A