

O.W.W.O.

Graham

KANSAS

SECTION 15 TOWNSHIP 8 RANGE 23 TNTWELL NO. #1 ~~Leflore~~ *Jones "B"*COMPANY ~~Hodel & Cushman~~ *Imperial*

NORTH

NW SW NW

WEST

EAST

0							

SOUTH

Graham

KANSAS

SEC.	TWP.	R.
15	8	23 W

WELL NO.

1 LeGere

FARM

COMPANY

Nadel & Gussman

CONTRACTOR

Co. tools

Wildcat


Ft. from N. Line

Ft. from S. Line

Ft. from E. Line

Ft. from W. Line

NW SW NW

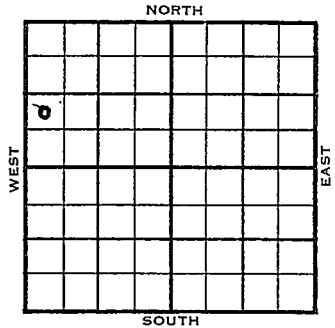

SDX - 1 Mile

	ELEVATION	REPORT
1955	2185'	

11/23	Location
12-1	Spud 11-26-55 8 5/8" @ 175/125 Anhy 1837 Drlg. 2170'
12-7	DST 3475-91 op 1 hr. 15 min., rec. 20' ocm, 10' hocm, 0# DST 3519-35 op 1 hr. rec 230' sw, 1170/20" D & A Tp. 3235 H. 3411 Tr. 3438 L. 3454 BKC 3671 A. 3847 TD 3877'

ABANDONED

WILDCAT

O.W.W.O.

S-513-B

County Graham Elev. 2185DF
 Sec. 15 Twp. 8 Rge. 23W
 Company Imperial
 Farm Name Jones "B" No. 1

TOPS	DEPTH	LOG	DATUM
Anh.			
Tp.			
H.			
Tr.			
Dg.			
B.L.			
L. <u>KC</u>	<u>3454</u>		
K.C.			
B.K.C.			
Ce.			
C.			
M.			
M.			
K.			
Mz.			
Mq.			
V.			
S.			
S.			
A.	<u>3847</u>		
R.			
Pf.			
G.			
T.D. <u>OTD</u>	<u>3877</u>		


Loc. in Sec. NW SW NW

(O.W.W.O.)

Geol. O.W.W.O.

Contr. V

Pool Wildcat

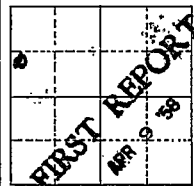

Date Comm. _____
 OLD INFO: Was Nadel & Gussman, tops D.&A.
 NEW INFO: MIRT DD 5" @ 3887 w/150, TD 3887,
WOCT

~~Top. Pool~~
~~Co. Prod.~~
O.W.W.O.

S-513-B

Co.

County Graham Elev. 2185 DF
Sec. 15 Twp. 8 Rge. 23W
Company Imperial
Farm Name Jones "B" No. 1

TOPS	DEPTH	LOG	DATUM
Anh.			
Tr.			
H.			
Dg.			
B.L.			
L. <u>KC</u>	<u>3454</u>		
K.C.			
B.K.C.			
Ce.			
C.			
M.			
M.			
K.			
Mz.			
Mq.			
V.			
S.			
S.			
A.	<u>3847</u>		
R.			
Pf.			
G.			
T.D. <u>OTD</u>	<u>3877</u>		

Loc. in Sec. NW SW NW

(O.W.W.O.)

Geol. O.W.W.O.

Contr.

Pool

Wildcat

		APR 16 '58
0		

ABANDONED

Lse.

Sec.

T.

R.

Date Comm.

OLD INFO: Was Nadel & Gussman, tops D. & A.

NEW INFO: MIRT DD 5" @ 3887 w/150, TD 3887,

WOCT APR 15 '58 co 16/3620-24 B 59M

50K oil 16/3604-08 B 1BM spk soil

110 A B 490 ph NW 3 hrs 1 \$1B

0 ph + Ld 6 hrs 4 \$580 ph + Ld

4 hrs dec to 130 ph NW 13 hrs

D & A

County Graham

Elev.

Sec. 75

Imp.Rae.

23W

Company Hotel & Gussman

FarmName 1 LeGere

No. 7

TOPS	DEPTH	LOG	DATUM
Anh.			
TP.			
H.			
Tr.			
Dg.			
BL.			
L.			
K.C.			
BK.C.			
Ce.			
C.			
M.			
M.			
K.			
Mz.			
Me.			
V.			
S.			
S.			
A			
R.			
PE.			
G.			
TD.			

Loc. in Sec.

ATAT SEA ATAT

Geol.

Control

Co. tools

Pool

W3dcat

NOV 23 '55
POST REPORT
1milz

Date Comm.

Location

5

Use


No.

Sec.

+

五

County Graham Elev. 2185
 Sec. 15 Twp. (8) Rge. 23W
 Company Nadel & Gussman
 Farm Name LeGere No. 1

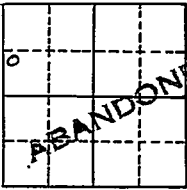TOPS	DEPTH	LOG	DATUM	Loc. in Sec.
Anh.	<u>1837</u>			NW SW NW
Tr.	<u>32.35</u>		<u>1050</u>	
H.	<u>34.11</u>		<u>1226</u>	
Tr.	<u>34.38</u>		<u>1253</u>	
Dg.				
Bl.				
L.	<u>3454</u>		<u>1269</u>	Geol.
K.C.				Contr.
B.K.C.	<u>3671</u>		<u>1486</u>	
Ce.				Co. tools
C.				
M.				Pool
M.				Wildcat
K.				
Mz.				
Me.				
V.				
S.				
S.				
A.	<u>3847</u>		<u>1662</u>	
R.				
Pe.				
G.				
T.D.	<u>3877</u>			

Date Comm. 11-26-55

DEC 7 1955

8 5/8" @ 175/125 DST 3475-91 open 1 hr
 15 min. rec. 20' ocm 10' hocm 0#
 DST 3519-35 open 1 hr. rec. 230' sw
 1170/20"

D & A