


SECTION 16 TOWNSHIP 8 RANGE 19W

WELL NO. #1 Katherine Peterson

COMPANY Nat'l Assoc. Petr.

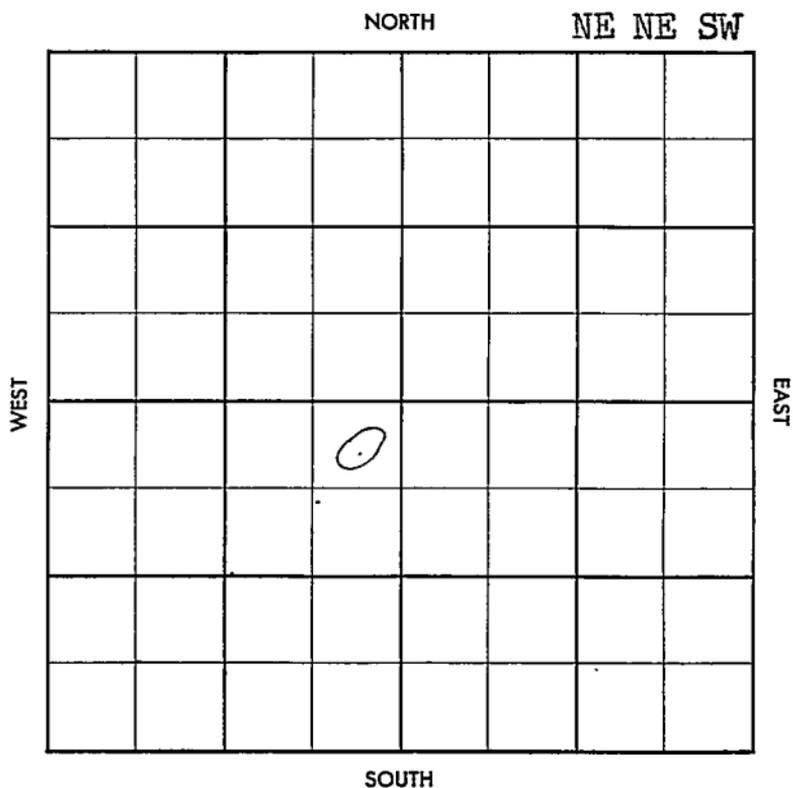


County Rooks Elev. _____
 Sec. 16 Twp. 8 Rgs. 19W
 Company Nat'l Assoc. Pet.
 Farm Name Katherine Peterson No. 1

TOPS	DEPTH	LOG	DATUM
Anh.	<u>1145-80</u>		
Tp.			
H.			
Tr.			
Dg.			
Bl.			
L.			
K.C.			
B.K.C.			
Ce.			
C.			
M.			
M.			
K.			
Mz.			
Mo.			
V.			
S.			
S.			
A.			
R.			
Pe.			
G.			
T.D.			

Loc. in Sec. NE NE SW
 Geol. _____
 Contr. _____
Prime Drlg.
 Pool _____
Webster

JUN 12 1957		
FIRST REPORT		

Date Comm. 6-7-57 Texas, C.S.O. & Carter-DHM
8" @ 213/185, Drlg. 2270

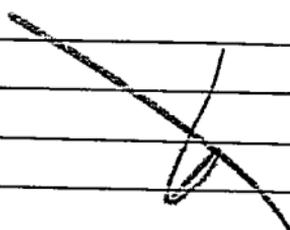

Co.
 Lse.
 No.
 Sec.
 T.
 R.

Co.

Sec.

No.

Sec.

T.

R.

County Rooks Elev. 2013
 Sec. 16 Twp. 8 Rge. 19W
 Company Lat'l Assoc. Pet.
 FarmName Katherine Peterson No. 1

TOPS	DEPTH	LOG	DATUM
Anh.	1115-80		
TP.	2976		
H.	3177		
Tr.	<u>Dodge</u> 3204		
Dg.			
Bl.			
L.	3217		
K.C.			
B.K.C.	3424		
Ce.			
C.	<u>sdg</u> 3487		
M.			
M.			
K.			
Mz.			
Me.			
V.			
S.			
S.			
A.	3508		
R.			
PE.			
G.			
T.D.	3565		

Loc. in Sec. _____
 NE 1/4 SW
 Geol. _____
 Contr _____
 Pool _____
 Well star _____

ABANDONED
 JUN 26 1937

Date Comm. 6-7-37 Texas, C.O.C. Center-ME.
213/185, Drl. 2270 DST

3240-66 2 hrs rec 30' MEW
+60' ME SW +640' SW DHT
840/20 DST 3280-3305
2 hrs rec 65' MEW +60' WET
BHT 1040/20 DST 3301-4
1 hr. rec 25' SSWCM BHT 505
120" DST 3341-83 " 40 hr
rec 30' ME BHT 1230/20

FORM 513-1 SUNRAY

DST 2457-90 1hr 15' Md

BHP 0120

DEW