


Mitchell

Form 51-5M-4-36-Palace

Section 16 Township 8 Range 10-W

Well Number #1 Greiss

Company Siedhoff et al

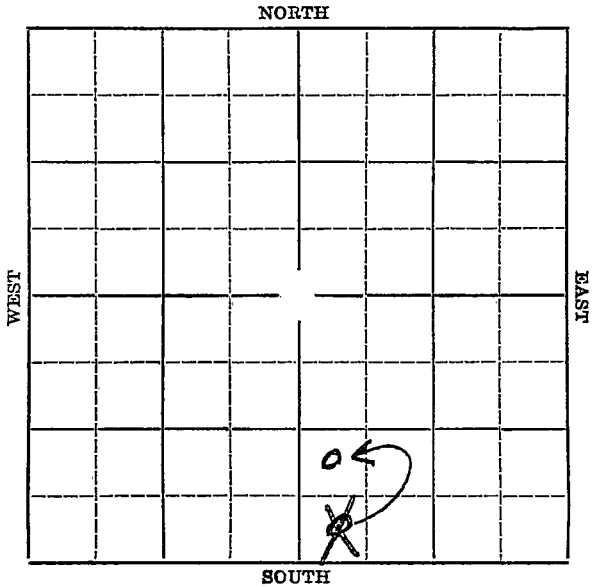



52-A-5M-7-36-Palace

KANSAS**Mitchell**Sec. 16 Twp. 8 R. 10-WWell No. 1 Greiss FarmSiedhoff et al Company

Ft. from N. Line

290
330


Ft. from S. Line

Ft. from E. Line

330

Ft. from W. Line

Elev. 1563

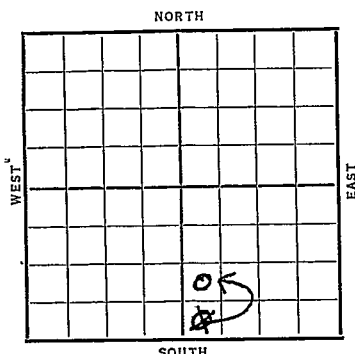~~1936~~

REPORT

11/4 R. O. G.

11/12 Building Rig.

11/19 20" @ 60' Spud 90'.

11/27 15" @ 440'. Drlg. 450'.

12/3 15" @ 522'. Drlg. 560'.

12/10 12" @ 725'. Drlg. 890'.

12/17 Drlg. 1500'.

12/24 10" @ 1840'. Drlg. 1903'.

12/29 Drlg. 2002'.

1937

1/7 Drlg. 2200'.

1/14 Shut down 2200'.

1/21 " " "

1/28 " " "

2/4 " " "

2/11 " " "

2/19 " " "

2/26 " " "

3/4 " " "

3/11 " " "

3/18 2280' under ream 10"

3/25 8" @ 2149'. Drlg. 2288'.

OVER OVER

1937

4/2 2364' under ream 8"

4/8 8" @ 2370' Drlg. 2620'

4/16 2660' under ream 8"

4/23 Drlg. 2750'.

4/30 Lansing 2710'.

T.D. 2845'.

Lowering 8".

5/7 T.D. 2890'. U.R. 8".

5/14 T.D. 3002'.

SD for 6" pipe.

5/21 T.D. 3011'. Rng. 6".

5/28 6" @ 3011'. Drlg. 3200'.

6/4 " " "

6/11 T. D. 3410'. U.R. 6".

6/19 " " " "

6/25 H.F.W. 3483'. T.D. 3502'.

U.R. 6".

7/2 6" @ 3435'. Drlg. 3524'.

7/9 T.D. 3524'. Rng. 5".

7/16 5" @ 3538'. T.D. 3548'.

SD for repairs.

7/23 T.D. 3565'. S.O. & G.

U.R. 5".

7/30 Drlg. 3616'.

8/6 5" @ 3633'. Drlg. 3700'.

8/13 5" @ 3696'. Drlg. 3725'.

8/20 Drlg. 3772'.

OVER

1937

8/28 Viola 3716'. 5" @ 3716'.

Drlg. 4022'.

9/3 " " "

9/10 " " "

9/17 Simp. 3970' H.F.W.

T.D. 4022' SD.

9/24 " " "

10/2 " " "

10/8 " " "

10/15 " " "

10/22 " " "

10/29 " " "

11/5 " " "

11/12 " " "

1963

11/17 K.C. 2710-3042'.

Miss. 3395-3640'.

Kinderhook 3640-3724'.

Mauve. 3724-43'.

Cherty Viola 3743-3800'.

Simp. 3970'.

Sil. 4047'.

T.D. 4053'.

ABANDONED

KANSAS

Map No. 57 Sec. 16 Twp. 8 R. 10WWell No. 1 GreissSuedhoff & Co Company
Contractor

SECTION PLAT

 Ft. from N. Line330 Ft. from S. Line Ft. from E. Line320 Ft. from W. Line

FIRST RECORD

Location Rig up

Drilling and Remarks:

LOG

RECORD

Cased in., ft.Sand Gas Oil Total Depth

PRODUCTION

1st 24 hrs. Nat. 1st 24 hrs. after shot Gas Cu. Ft.Dry Hole Abandoned

Date

NOV 4 1936₁₉S. J. LEWIS Scout

KANSAS

Map No. 57 Sec. 16 Twp. 8 R. 10W

Well No. 1 Greiss

Siedhoff & Co Company
Contractor

SECTION PLAT

990 Ft. from N. Line

990 Ft. from S. Line

330 Ft. from E. Line

330 Ft. from W. Line

CORRECTION

Location _____

Rig up _____

Drilling and Remarks:

*Reported
SWSE*

RECORD

Cased _____ in., _____ ft.

Sand _____

Gas _____

Oil _____

Total Depth _____

PRODUCTION

1st 24 hrs. Nat. _____

1st 24 hrs. after shot _____

Gas _____ Cu. Ft.

Dry Hole _____

Abandoned _____

Date

DEC 9 1936 19 S. J. LEWIS Scout

Mitchell

KANSAS

Map No. 57 Sec. 16 Twp. 8 R. 10WWell No. 1 GreissSiedhoff etal

Company

Contractor

ABANDONED

NW SW SE

Ft. from N. Line

990 Ft. from S. Line

Ft. from E. Line

330 Ft. from W. Line

SECTION PLAT

		0	

Location

Rig up

Drilling and Remarks:

K.C. 2710-3042

Miss 3395-3640

Kinderhook 3640-3724

Maguo. 3724-43

CherTy Viola 3743-3800

Simp 3970

Sil 4047

D & A

RECORD

Cased _____ in., _____ ft.

Sand Sil 4047

Gas

Oil

Total Depth 4053

PRODUCTION

1st 24 hrs. Nat. _____

1st 24 hrs. after shot _____

Gas _____ Cu. Ft.

Dry Hole _____

Abandoned _____

Date

NOV 17 1937 19

H. D. Hatfield Scout