FORM 51 10M 8-47


Rocks KANSAS

Section 16 Township 8 Range 18W

Well No. #1 Dickinson

Company C. U. Bay & Hinkle

Wildcat

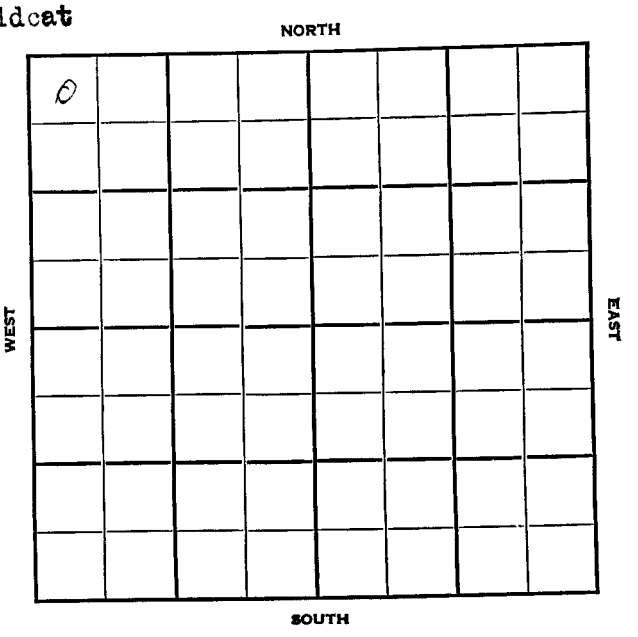

FORM 252-A
5M 9-47 PETROL

KANSAS Rooks ✓

Sec. 16 Twp. 8 R. 18W

Well No. #1 Dickinson Farm

C. U. Bay & Hinkle Company

Wildcat


330' Ft. from N. Line

Ft. from S. Line

Ft. from E. Line

330' Ft. from W. Line

NW/C

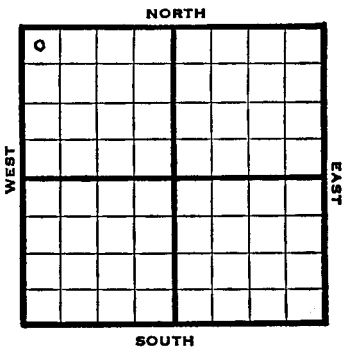

1948	Elev. 2003' REPORT
2/11	RUR
2/18	8"@ 1010' Drlg 2575'
2/25	Lans. 3183' Arb. 3505' TD 3560' Abd.

ABANDONED

Form 26 200 Bks. 10-46 Petrol

Kansas

Wildcat

Map No. _____ Sec. 16 Twp. 8 R. 18W

Well No. 1 Dickinson

C. U. Bay & Hinkle Company

FIRST REPORT Contractor

NW/C


330 Ft. from N. Line

_____ Ft. from S. Line

_____ Ft. from E. Line

330 Ft. from W. Line

SECTION PLAT

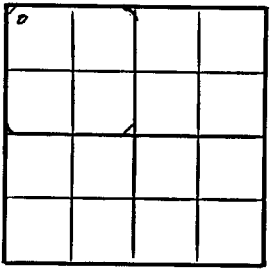

Rooks County

Location _____

Rig up _____

Drilling and Remarks:

R U R

RECORD

Cased _____ in., _____ ft.

Sand _____

Gas _____

Oil _____

Total Depth _____

PRODUCTION

1st 24 hrs. Nat. _____

1st 24 hrs. after shot _____

Gas _____ Cu. Ft.

Dry Hole _____

Abandoned _____

Date

FEB 11 1948 19 S. J. LEWIS Scout

Form 26—200 Bks.—1-48—Palace

Wildcat

Kansas

Map No. 64 Sec. 16 Twp. 8 R. 18W

Well No. 1 Dickinson


C. KU. Bay & Hinkle Company

ABANDONED Contractor

NW/C

£1,204'

SECTION PLAT

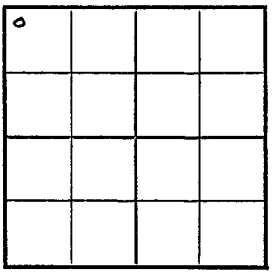

330 Ft. from N. Line

Ft. from S. Line

Ft. from E. Line

330 Ft. from W. Line

Rooks County

Location

Rig up

Drilling and Remarks:

Lans 8/83

Ck 72805

RECORD

Cased in., ft.

Sand

Gas

Oil

Total Depth 3860

PRODUCTION

1st 24 hrs. Nat.

1st 24 hrs. after shot

Gas Cu. Ft.

Dry Hole

Abandoned

Date

FEB 25 1948 19

S. J. LEWIS Scout