

Graham

DX 78-1

KANSAS

Section 16 Township 8 Range 25W

Well No. #1 Lunney


Company Empire Drlg.

NORTH

7

WEST

EAST

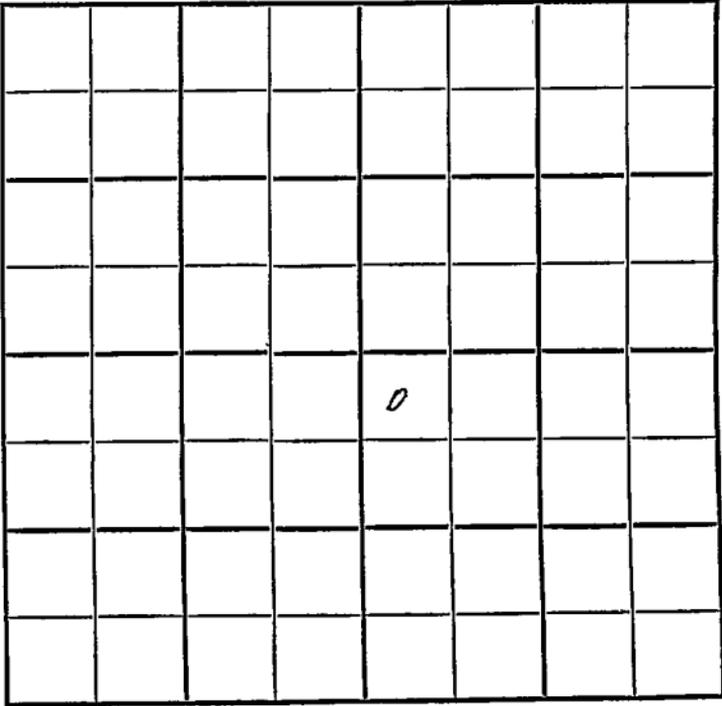

SOUTH

10

Graham KANSAS


SEC.	TWP.	R.
16	8	25W

WELL NO. 1 Lunney FARM

COMPANY Empire Drlg.

CONTRACTOR Empire Drlg.
Schmeid Pool

330 Ft. from N. Line
 _____ Ft. from S. Line
 _____ Ft. from E. Line
 330 Ft. from W. Line

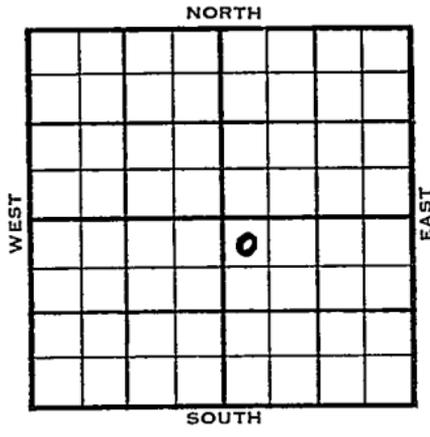

NW NW SE

	ELEVATION	REPORT
1954	2353'	
8-25	Spdg 8-23-54 8" @ 166	
9/8	WOC Spud 8-23-54 D & A TD 3912 8" @ 166 Heb 3628 Tor. 3647 Lans 3662 B KC 3890 TD 3912 D & A	
ABANDONED		


County Graham State Kansas

Sec. 16 (Blk. 8) (Sur. Rge.) 25W Map No.

Operator Empire Drlg.

Well No. 1 Farm Lunney

Elev. _____ Location NW NW SE

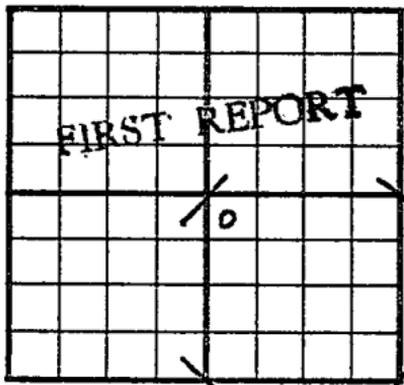

330 Ft. From N Line SE

330 Ft. From W Line Quarter

Ist. Report AUG 25 1954

Completion _____

Remarks _____

Empire Drlg. - Contr.

Spudding Date 8-23-54

Drlg. Data Schmeid Pool

8" @ 166 WOC


County Graham State Kansas

Sec. 16 (Blk. Twp.) 8 (Sur. Rge.) 25W Map No.

Operator Empire Drlg.

Well No. 1 Farm Lunney

Elev. 2353 Location NW NW SE

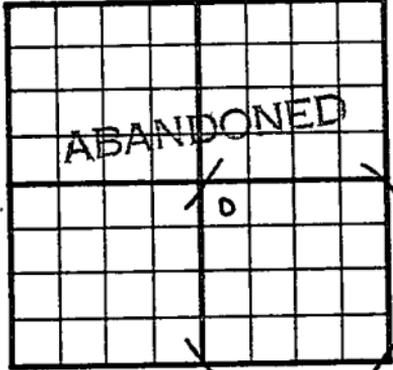

330 Ft. From N Line SE

330 Ft. From W Line Quarter

Ist. Report

Completion SEP 8 1954

Remarks Schmeid Pool

Empire Drlg. - Contr.

Spudding Date 8-23-54

Drlg. Data D & A TD 3912

8" @ 166 Heeb. 3628 Tor. 3647

Lans. 3662 B KC 3890 TD 3912

D & A

FABEN GILSTRAP