

Graham


FORM 51

KANSAS

Section 16 Township 8 Range 25W

Well No. #1 Madden-Davis "A"

Company Empire Drlg.

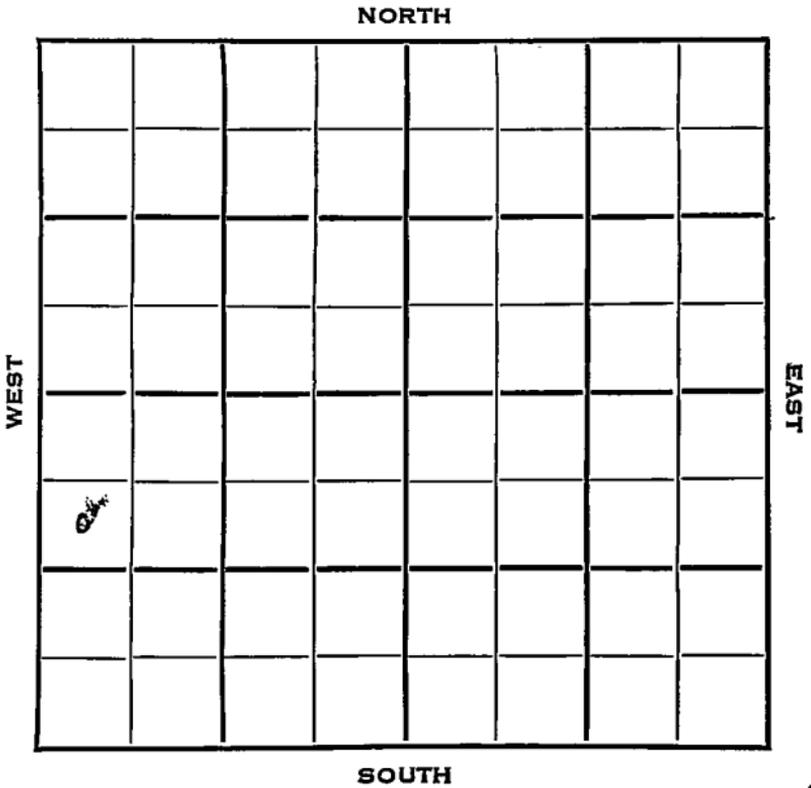

12

Graham

KANSAS

SEC.	TWP.	R.
16	8	25W

WELL NO. #4 Madden-Davis "A" FARM

COMPANY Empire Drlg.

CONTRACTOR Empire Drlg.

Schmeid Pool

NORTH


990 Ft. from N. Line

Ft. from S. Line

Ft. from E. Line

330 Ft. from W. Line

SW NW SW

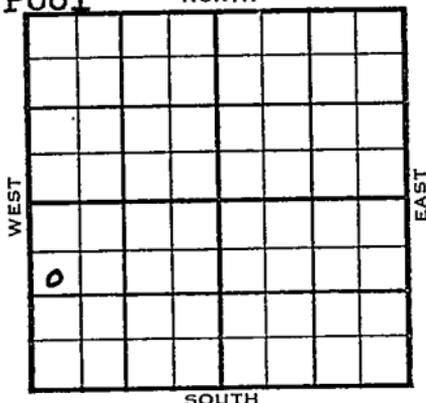

1954

ELEVATION

2355'

REPORT

4/7

Spud 4-5-54  
8" @ 156'

WOC

4/14

WOC

5/12

Spud 4-5-54 Oil well TD 3809  
 8" @ 156 Anhy 2060 Heeb 3602  
 Tor. 3623 Lans. 3639 TD 3809  
 5" @ 3798 CO to 3809 S & F/174  
 BO 2 hr. S & F/24 BOPH  
 Comp. 3000 BOPD

**COMPLETED**



