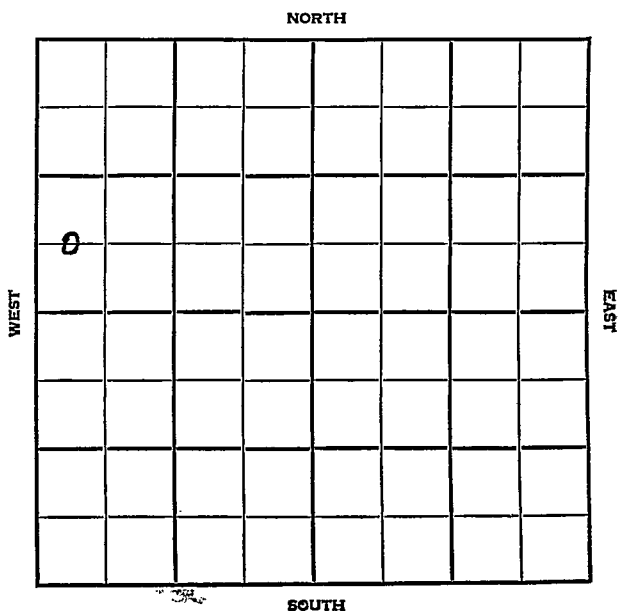


Section 16 Township 8 Range 25WWell No. 6 Madden-Davis "A"Company Empire Drlg.

5

Graham

KANSAS

SEC.	TWP.	R.
16	8	25W ✓

WELL NO.

6 Madden-Davis "A"

FARM

COMPANY

Empire Drlg.

CONTRACTOR

Empire Drlg. Contr.

Scheid Pool

_____ Ft. from N. Line


660

_____ Ft. from S. Line

_____ Ft. from E. Line

330

_____ Ft. from W. Line

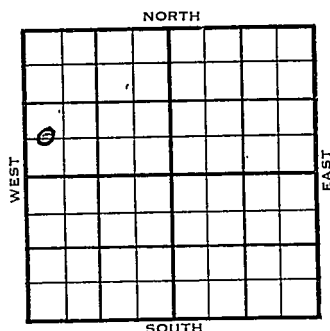CW $\frac{1}{2}$ SW NW

1954

ELEVATION

2343

REPORT

1954

6/2

8" @ 155

WOC

Spud 5-30-54

6/9

Drlg. 3795'

6/30

Spudding 5-30-54

Oil well

TD 3795

8" @ 155

Heeb 3589 Tor. 3609 KC 3622

TD 3795

5" @ 3784

CO to 3795 3000 A S/ 30 boph

8 hr.

Comp. 3000 bopd

COMPLETED

County Graham State KansasSec. 16 (Blk.) 8 (Sur.) 25W Map No.Operator Empire Drlg.Well No. 6 Farm Madden-Davis "A"Elev. Location C W $\frac{1}{2}$ SW NW

FIRST REPORT


660 Ft. From S Line NW330 Ft. From W Line Quarter1st. Report JUN 2 1954

Completion

Remarks

Empire Drlg. - Contr.Spudding Date 5-30-54Drlg. Data Schmeid Pool8" @ 155 WOG

County Graham State Kansas
 Sec. 16 (Blk. 8) (Sur. 25W) (Twp.) Map No.
 Operator Empire Drlg.
 Well No. 6 Farm Madden-Davis "A"
 Elev. 2343 Location C W $\frac{1}{2}$ SW NW

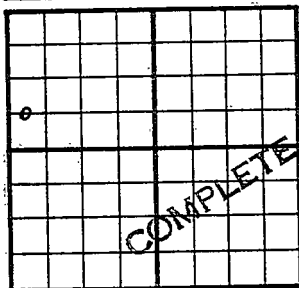

660 Ft. From S Line NW
330 Ft. From W Line Quarter

1st. Report

Completion JUN 30 1954

Remarks Schmeid Pool

Empire Drlg. - Contr.

Spudding Date 5-30-54

Drlg. Data Oil well TD 3795

8" @ 155 Heeb. 3589 Tor. 3609

KC 3622 TD 3795 5" @ 3784

CO to 3795 3000 A S/ 30 boph. 8 hr.

Comp. 3000 bopd

J. G. McGEHEE