
FORM 51 25M 8-50 WESTERN

Graham KANSAS

Section 16 Township 8 Range 25 W

Well No. # 1 Madden

Company Empire Drlg.

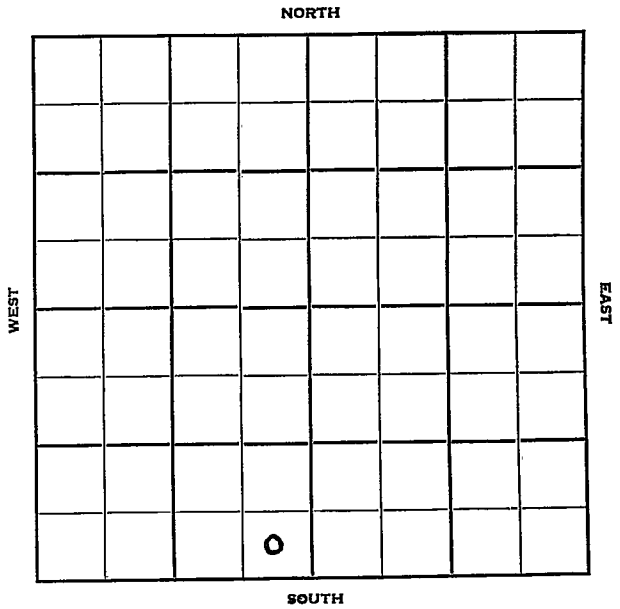

14

FORM 252-B
10M 8-51 TPCO. Graham KANSAS ✓

Sec. 16 Twp. 8 R. 25W

Well No. #1 Madden Farm

Empire Drlg. Company

Contractor


Ft. from N. Line

330' Ft. from S. Line

330' Ft. from E. Line

Ft. from W. Line

SE SE SW

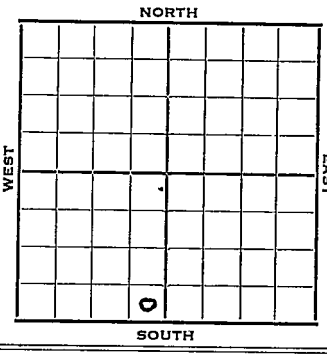

1952	Elev. 2299' REPORT
6/4	Location
6/11	"
6/18	"
6/25	"
7/2	RUR
7/9	8" @ 194 Anhy 2049 Drlg. 3402'
7/17	Topeka 3381 Heeb. 3591 Tor 3617 Lans. 3634 BKC 3848 RTD 3870 5" @ 3869
7/23	CO 3834' Ran Gamma ray 24/ 3795-3801 20 goph 1500 A S/ 3 BO & 1 Bwph 5 hrs. POP
7/30	NR
8/6	"
8/13	"
8/20	"
8/27	"
9/3	P/57 Bopd
9/10	P/64 BOPD
9/17	NR
9/24	NR
10/1	Spud 7-1-52 Oil well TD 3870' 8" @ 194' Anhy 2049' Top 3381' Heeb 3591' Tor. 3617' Lans. 3634' OVER

1952
10/1 (Information continued)
DST 3647-67 open 1 hr, rec 470' muddy GCSW 1230#
DST 3697-3717 open 1 hr. rec 255' mud & GCSW 1270#
DST 3753-64 open 1 hr. rec 150' mud VSSO 1100#
DST 3767-3804 open 1 hr, rec 150' VHO & GCM B KC 3848' TD 3870'
5" @ 3869' CO to 3834 24/3795-3801
20 goph 1500 A S/3 BO 1 BWPH
P/50 BOPD P/57 BOPD P/64 BOPD
Comp. 80 BOPD 30% water.

COMPLETED

FORM 275 FOR SALE BY KANSAS BLUE PRINT CO.


County Graham State Kansas

Sec. 16 (Blk. Twp.) 8 (Sur. Rge.) 25W Map No.

Operator Empire Drlg.

Well No. 1 Farm Madden

Elev. 2299 Location SE SE SW

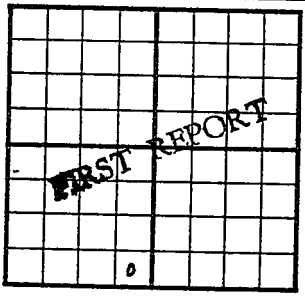

330 Ft. From S Line SW

330 Ft. From E Line Quarter

1st. Report JUN 4 1952

Completion

Remarks

Spudding Date

Drlg. Data

Location

J. G. McGEHEE

FORM 275 FOR SALE BY KANSAS BLUE PRINT CO.


County Graham State Kansas

Sec. 16 (Blk. Twp.) 8 (Sur. Rge.) 25W Map No.

Operator Empire Drlg.

Well No. 1 Farm Madden

Elev. 2299 Location SE SE SW

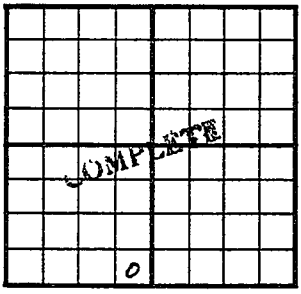

330 Ft. From S Line SW

330 Ft. From E Line Quarter

1st. Report

Completion OCT 1 1952

Remarks

Spudding Date 7-1-52

Drlg. Data Oil well TD 3870

8" @ 194 Anhy 2049 Top. 3381

Heeb. 3591 Tor. 3617 Lans. 3634

DST 3647-67 open 1 hr. Rec. 470' muddy gcsw 1230# DST 3697-3717 open 1 hr. Rec. 255' mud & gcsw 1250# DST 3753-64 open 1 hr. Rec. 150' mud VSSO 1100# DST 3767-3804 open 1 hr. Rec. 150' vho & gcm B KC 3848 TD 3870 5" @ 3869 CO to 3834 24/ 3795-3801 20 goph 1500 A S/ 3 bo 1 bwph P/ 50 bopd P/ 57 bopd P/ 64 bopd Comp. 80 bopd 30% wtr.

J. G. McGUIRE