


Graham

KANSAS

SECTION 16 TOWNSHIP 8S RANGE 23W

WELL NO. #1 Ralph G. Bethell

COMPANY Magnolia Petr.

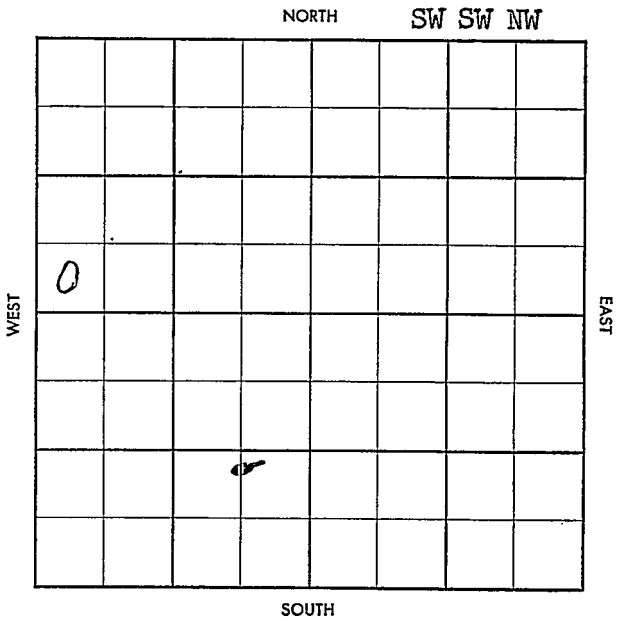

S-513-A

CO. Graham

ELEV. 2181 RB
21780 F

SEC. 16

TWP. 18

RGE. 23W

FEB 12 '58

COMPANY Magnolia Pet. Co. 1

COMPLETE

CO

LSE

NO.

SEC.

TWP.

RGE

FARM Ralph C. Bethell

LOC. SW SW NW

<u>H 3395</u>
<u>TR 3420</u>
<u>L 3436</u>
<u>TD 3670</u>

GEOL. _____
CONTR. J-S-F 1st
POOL Higer
SPUD 1-17-58

Location JAN 22 '58 8"
330/250 @ 2485
JAN 29 '58 DST 3455
-75 60" g/13" TSTN
900' gassy oil 120
MC gassy oil 60"

VH 0' c 6 g cm FP 60-37C
BHP 1260/40" DST 3608-30
60" 25' M FPO BHP 100/20"

ran log top H 3395
TR 3419 L 3436 BKC 3647
5 1/2" 3669/150 WOCT FEB 5 '58

CO. 3654 16/3597-3601
B 2990 ph NW 4 hrs 2 \$90
BO NW 10 hrs g 36.6°
500' OB POP FEB 12 '58 PhyPot

124 BOPd NW g 36°

25 BOPd NW