

Section 16 Township 8 Range 20 WWell No. # 1 BurrtonCompany Deep Rock

NORTH

0							

WEST

EAST

SOUTH

Rooks

8

20W

Sec. 16

Twp.

R.

Well No. #1 Burrton

Farm

Deep Rock

Company

Wildcat

Contractor

Ft. from N. Line

330'

Ft. from S. Line


Ft. from E. Line

330'

Ft. from W. Line

SW SW SW

Phillips & Amerada DHM

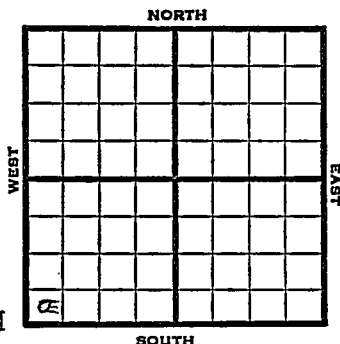

1951

Elev. 1992' REPORT

6/20

Location

7/11

Spud 6-25-51

D&A TD 3590

8" @ 220

Anhy 1568 Heeb. 3201 Lans. 3239

DST 3306-48 opn 1 hr. Rec. 1440'

sw DST 3380-3460 opn 1/2 hr

Rec. 5' mud Arb. 3548

DST 3551-60 opn 1/2 hr Rec. 10'

mud DST 3558-90 opn 1 hr


Rec. 140' sw

D&A

ABANDONED

J. E. TYRA

County Rooks State Kan
 Sec. 16 (Blk. 8) (Sur. 20W) (Twp. 8) Map No. 20W
 Operator Deep Rock
 Well No. 1 Farm Burrtton
 Elev. 1992 Location SW SW SW

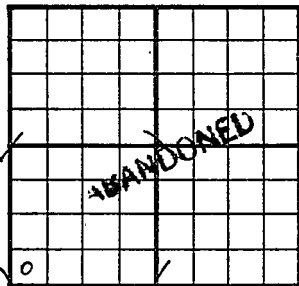

330 Ft. From S Line SW
330 Ft. From W Line Quarter

Ist. Report

Completion JUL 11 1951

Remarks Wildcat

Spudding Date 6-25-51

Drilg. Data D & A TD 3590

8" @ 220 Anhy 1568 Heeb. 3201

Lans. 3239 DST 3306-48 open 1 hr.

Rec. 1440' sw DST 3380-3460

open $\frac{1}{2}$ hr. Rec. 5' mud Arb. 3548

DST 3551-60 open $\frac{1}{2}$ hr. Rec. 10'

mud DST 3558-90 open 1 hr.

Rec. 140' sw

D & A

J. E. TYRA